



BUTANO CREEK CHANNEL RECONNECTION
AND RESILIENCE PROJECT

SAN MATEO COUNTY, CALIFORNIA

SAN MATEO RESOURCE CONSERVATION DISTRICT AND
CALIFORNIA DEPARTMENT OF PARKS AND RECREATION

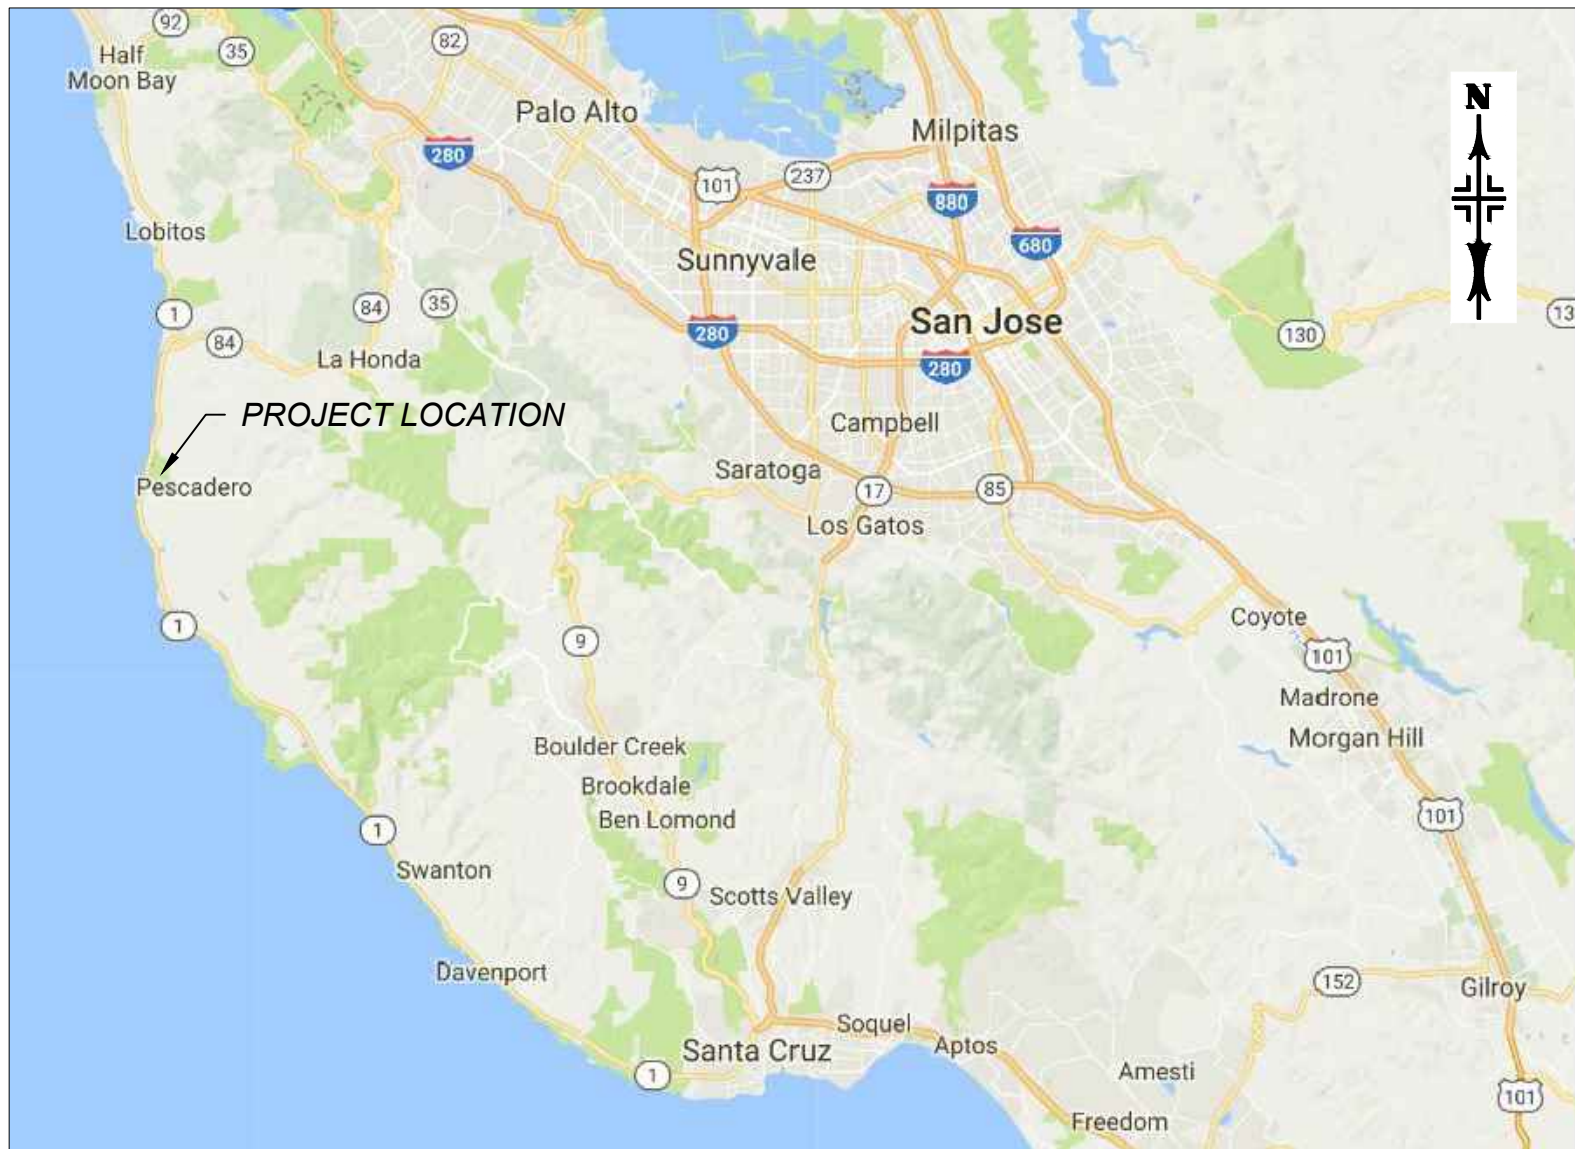

PROJECT VICINITY MAP
(NOT TO SCALE)

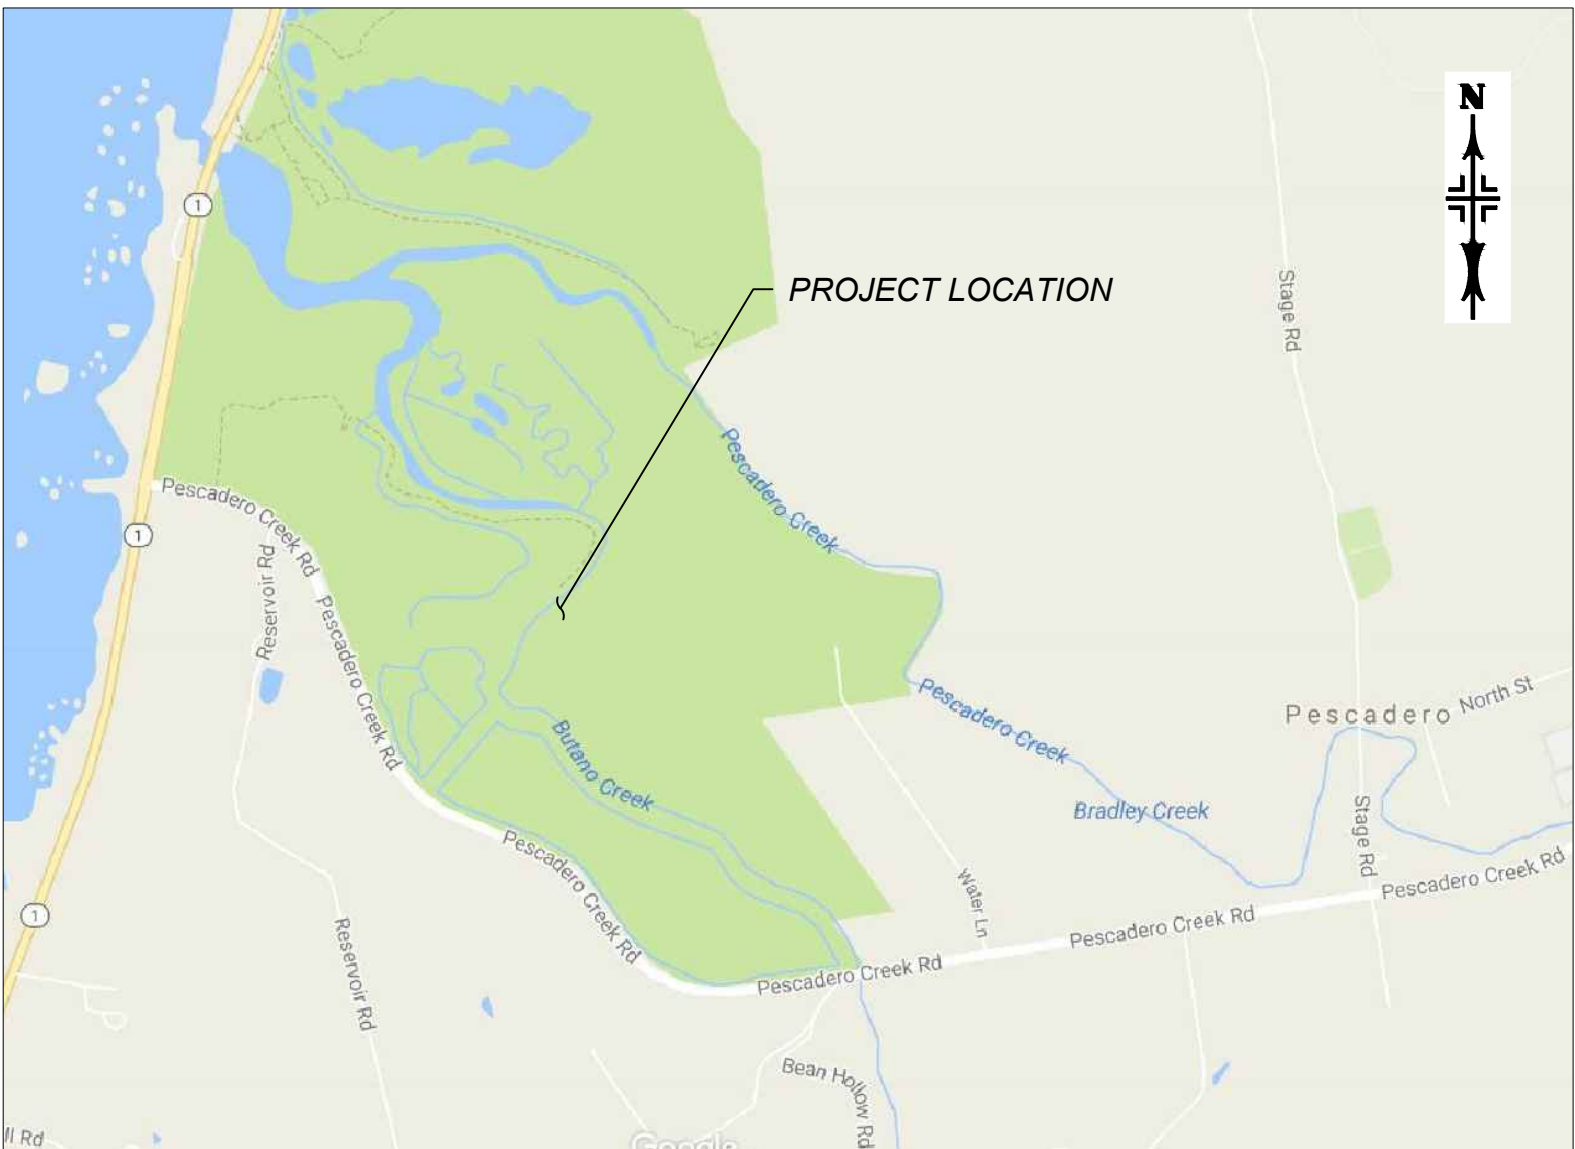

PROJECT LOCATION MAP
(NOT TO SCALE)

CONTACTS

SMRCD	KELLYX NELSON , EXECUTIVE DIRECTOR	(650) 712-7765 X 102
ALNUS ECOLOGICAL	JIM ROBINS, PROJECT MANAGER	(510) 332-9895
CA DEPARTMENT OF PARKS AND RECREATION	TIM HYLAND, PROJECT MANAGER	(831) 335-6384
CA DEPARTMENT OF PARKS AND RECREATION	CHRIS SPOHRER, DISTRICT SUPERINTENDENT	(831) 335-6390
cbec, inc.	CHRIS HAMMERSMARK, PROJECT ENGINEER	(916) 668-5236

CONTOURS AND ELEVATIONS SHOWN ON PLANS CONSIST OF NATIONAL OCEANIC AND ATMOSPHERIC ADMINISTRATION (NOAA) LIDAR SUPPLEMENTED WITH CBEC'S SITE TOPOGRAPHY COLLECTED IN NOVEMBER 2016 (BUTANO CREEK BATHYMETRY/TOPOGRAPHY) AND FEBRUARY AND APRIL 2017 (MARSH TOPOGRAPHY). CBEC SITE SURVEY OF BUTANO MARSH AND CREEK WAS TIED INTO NATIONAL GEODETIC SURVEY FIRST ORDER, CLASS 1, VERTICAL CONTROL POINT HT1506 LOCATED AT LAT:37°15'34.4", LONG:122°24'46.9" WITH A PUBLISHED ELEVATION OF 50.31 FT (NAVD88, GEOID 09). SURROUNDING TOPOGRAPHY IS FROM THE NATIONAL OCEANIC AND ATMOSPHERIC ADMINISTRATION 2009-2011 LIDAR DATASET.

NOTE: CONTRACTOR IS RESPONSIBLE FOR COMPLYING WITH ALL APPLICABLE PERMITS.

SHEET LIST TABLE

Sheet Number	Sheet Title
C1	COVER SHEET
C2	EXISTING CONDITIONS
C3	ACCESS AND STAGING PLAN
C4	SHEET LAYOUT PLAN
C5	PLAN VIEW (1 OF 7)
C6	PLAN VIEW (2 OF 7)
C7	PLAN VIEW (3 OF 7)
C8	PLAN VIEW (4 OF 7)
C9	PLAN VIEW (5 OF 7)
C10	PLAN VIEW (6 OF 7)
C11	PLAN VIEW (7 OF 7)

SHEET LIST TABLE

Sheet Number	Sheet Title
C12	CHANNEL PROFILE (1 OF 2)
C13	CHANNEL PROFILE (2 OF 2)
C14	SECTIONS
C15	ALIGNMENT GEOMETRY TABLE
C16	MARSH CONTROL STRUCTURE DETAILS
C17	WATER QUALITY BERM ENHANCEMENT DETAILS
C18	ENGINEERED LOG JAM PLAN AND SECTION
C19	PESCADERO LAGOON WATER SURFACE ELEVATION CONTROL

USE OF DOCUMENTS
THIS DOCUMENT, INCLUDING
THE INCORPORATED
SHEETS, IS THE PROPERTY
OF CBEC, INC. IT IS TO BE
USED FOR THE PROJECT
ONLY AND SHALL NOT BE
REPRODUCED OR
TRANSMITTED IN ANY
FORM OR BY ANY
MEANS, ELECTRONIC OR
MECHANICAL, WITHOUT
WRITTEN AUTHORIZATION
OF CBEC, INC.

DOCUMENT RELEASE
AS-BUILT

DESIGNED
CH/JS/SD

DRAWN
JP/JM

REVIEWED
SD

APPROVED
CH

PREPARED BY:

eco engineering

CLIENT:
SAN MATEO RESOURCE CONSERVATION DISTRICT
80 STONE PINE ROAD #100
HALF MOON BAY, CA 94019
(650) 712-7765

CALIFORNIA
PESCADERO
BUTANO CREEK CHANNEL RECONNECTION
AND RESILIENCE PROJECT
COVER SHEET

JOB NUMBER
16-1027-4

DATE
DEC 2019

SHEET
C1
1 OF 19

A

B

C

D


E

1

2

3

4

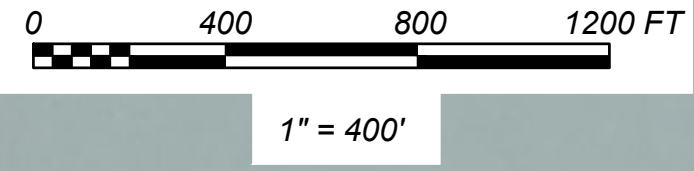

LEGEND:
- - - - - PROPERTY BOUNDARY
———— BUTANO CREEK

USE OF DOCUMENTS
THIS DOCUMENT, INCLUDING
THE INCORPORATED
DESIGN, SHALL BE THE
PROPERTY OF CDEC, INC.
IT IS NOT TO BE
REPRODUCED OR
TRANSMITTED IN ANY
FORM OR BY ANY
MEANS, ELECTRONIC OR
MECHANICAL, INCLUDING
PHOTOCOPYING, RECORDING,
OR BY ANY INFORMATION
SYSTEM, WITHOUT THE
WRITTEN AUTHORIZATION
OF CDEC, INC.

DOCUMENT RELEASE	
DESIGNED	AS-BUILT
CH/JS/SD	
DRAWN	REVISION NOTES
JP/JM	
REVIEWED	
SD	
APPROVED	
CH	

PREPARED BY:



CLIENT:

SAN MATEO
RESOURCE CONSERVATION DISTRICT
80 STONE PINE ROAD #100
HALF MOON BAY, CA 94019
(650) 712-7765




PESCADERO


CALIFORNIA

**BUTANO CREEK CHANNEL RECONNECTION
AND RESILIENCE PROJECT**

EXISTING CONDITIONS

JOB NUMBER	16-1027-4
DATE	DEC 2019
SHEET	C2
	2 OF 19

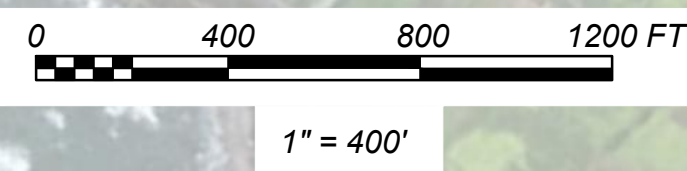

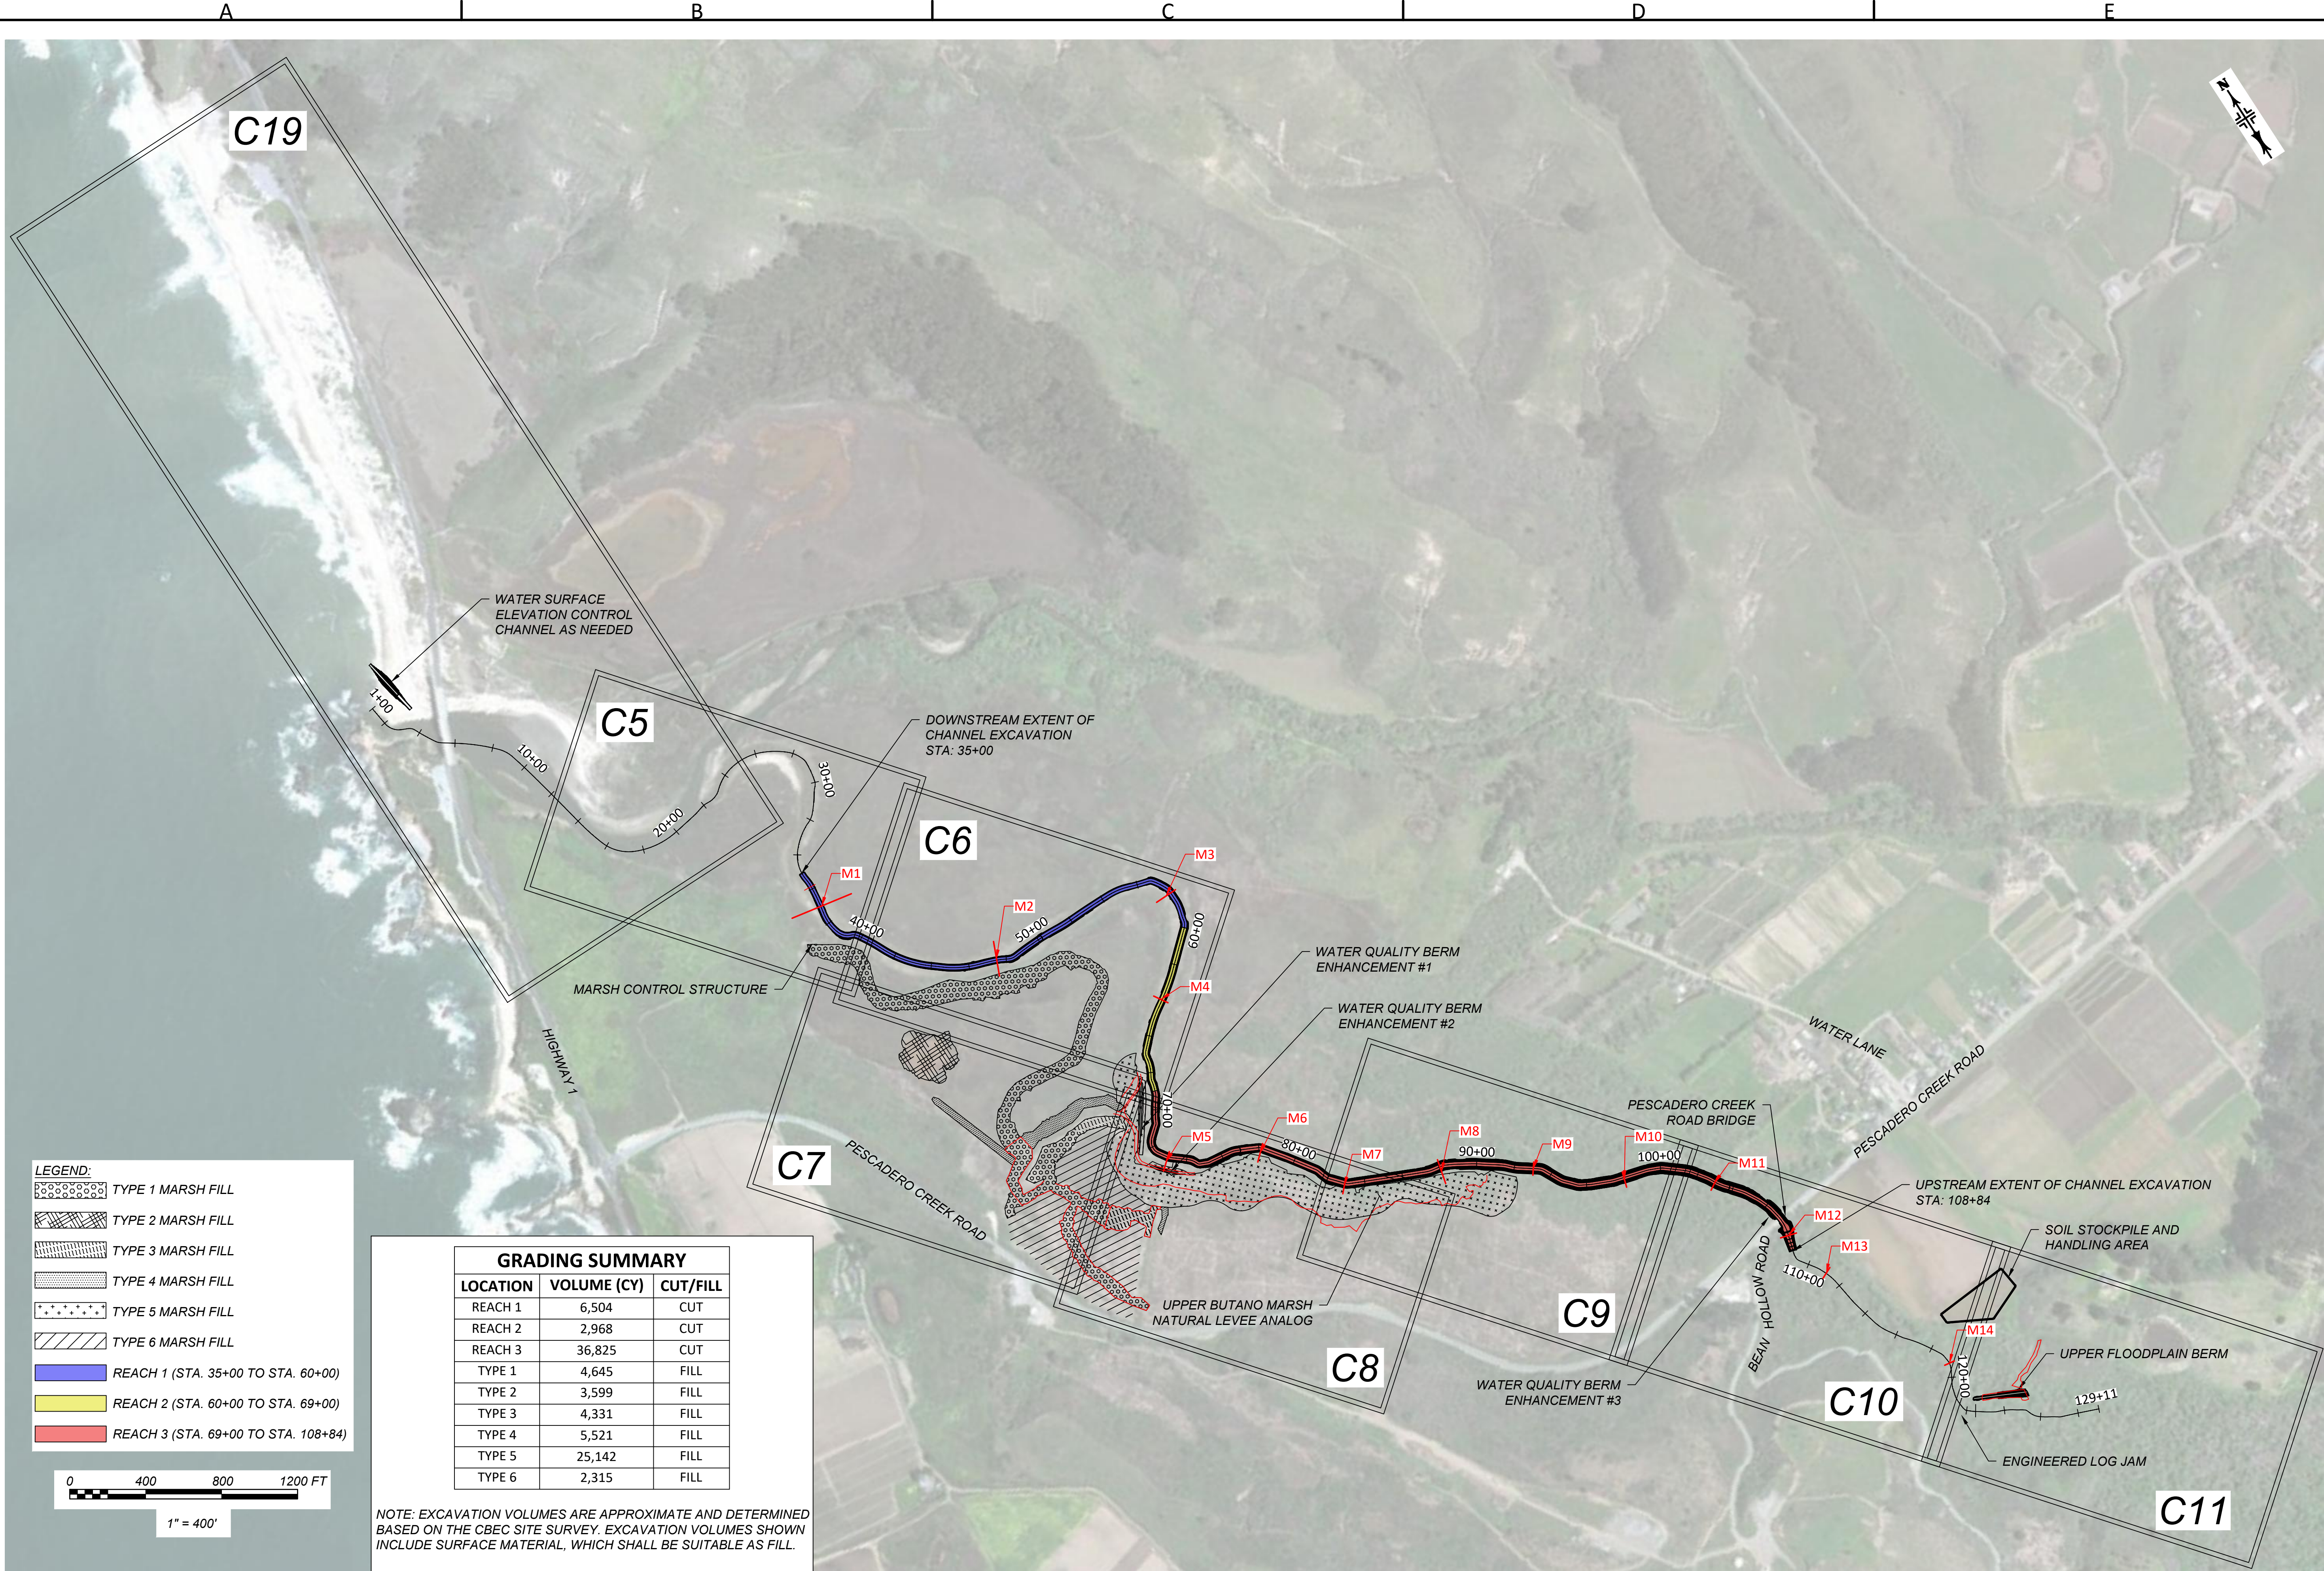

USE OF DOCUMENTS
THIS DOCUMENT, INCLUDING
THE INCORPORATED
DRAWINGS, SHALL BE
THE PROPERTY OF CBEC
AND SHALL NOT BE
REPRODUCED OR
TRANSMITTED IN ANY
FORM OR BY ANY
MEANS, ELECTRONIC
OR MECHANICAL,
INCLUDING PHOTOCOPYING,
RECORDING, OR BY
ANY INFORMATION
SYSTEM, WITHOUT THE
WRITTEN AUTHORIZATION
OF CBEC, INC.

DESIGNED
CH/JS/SD
DRAWN
JP/JM
REVIEWED
SD
APPROVED
CH

DOCUMENT RELEASE
AS-BUILT
REVISION NOTES

PREPARED BY:

eco engineering

SAN MATEO
RESOURCE CONSERVATION DISTRICT

80 STONE PINE ROAD #100
HALF MOON BAY, CA 94019
(650) 712-7765

CALIFORNIA
BUTANO CREEK CHANNEL RECONNECTION
AND RESILIENCE PROJECT


SHEET LAYOUT PLAN

PESCADERO

JOB NUMBER
16-1027-4

DATE
DEC 2019

SHEET
C4
4 OF 19

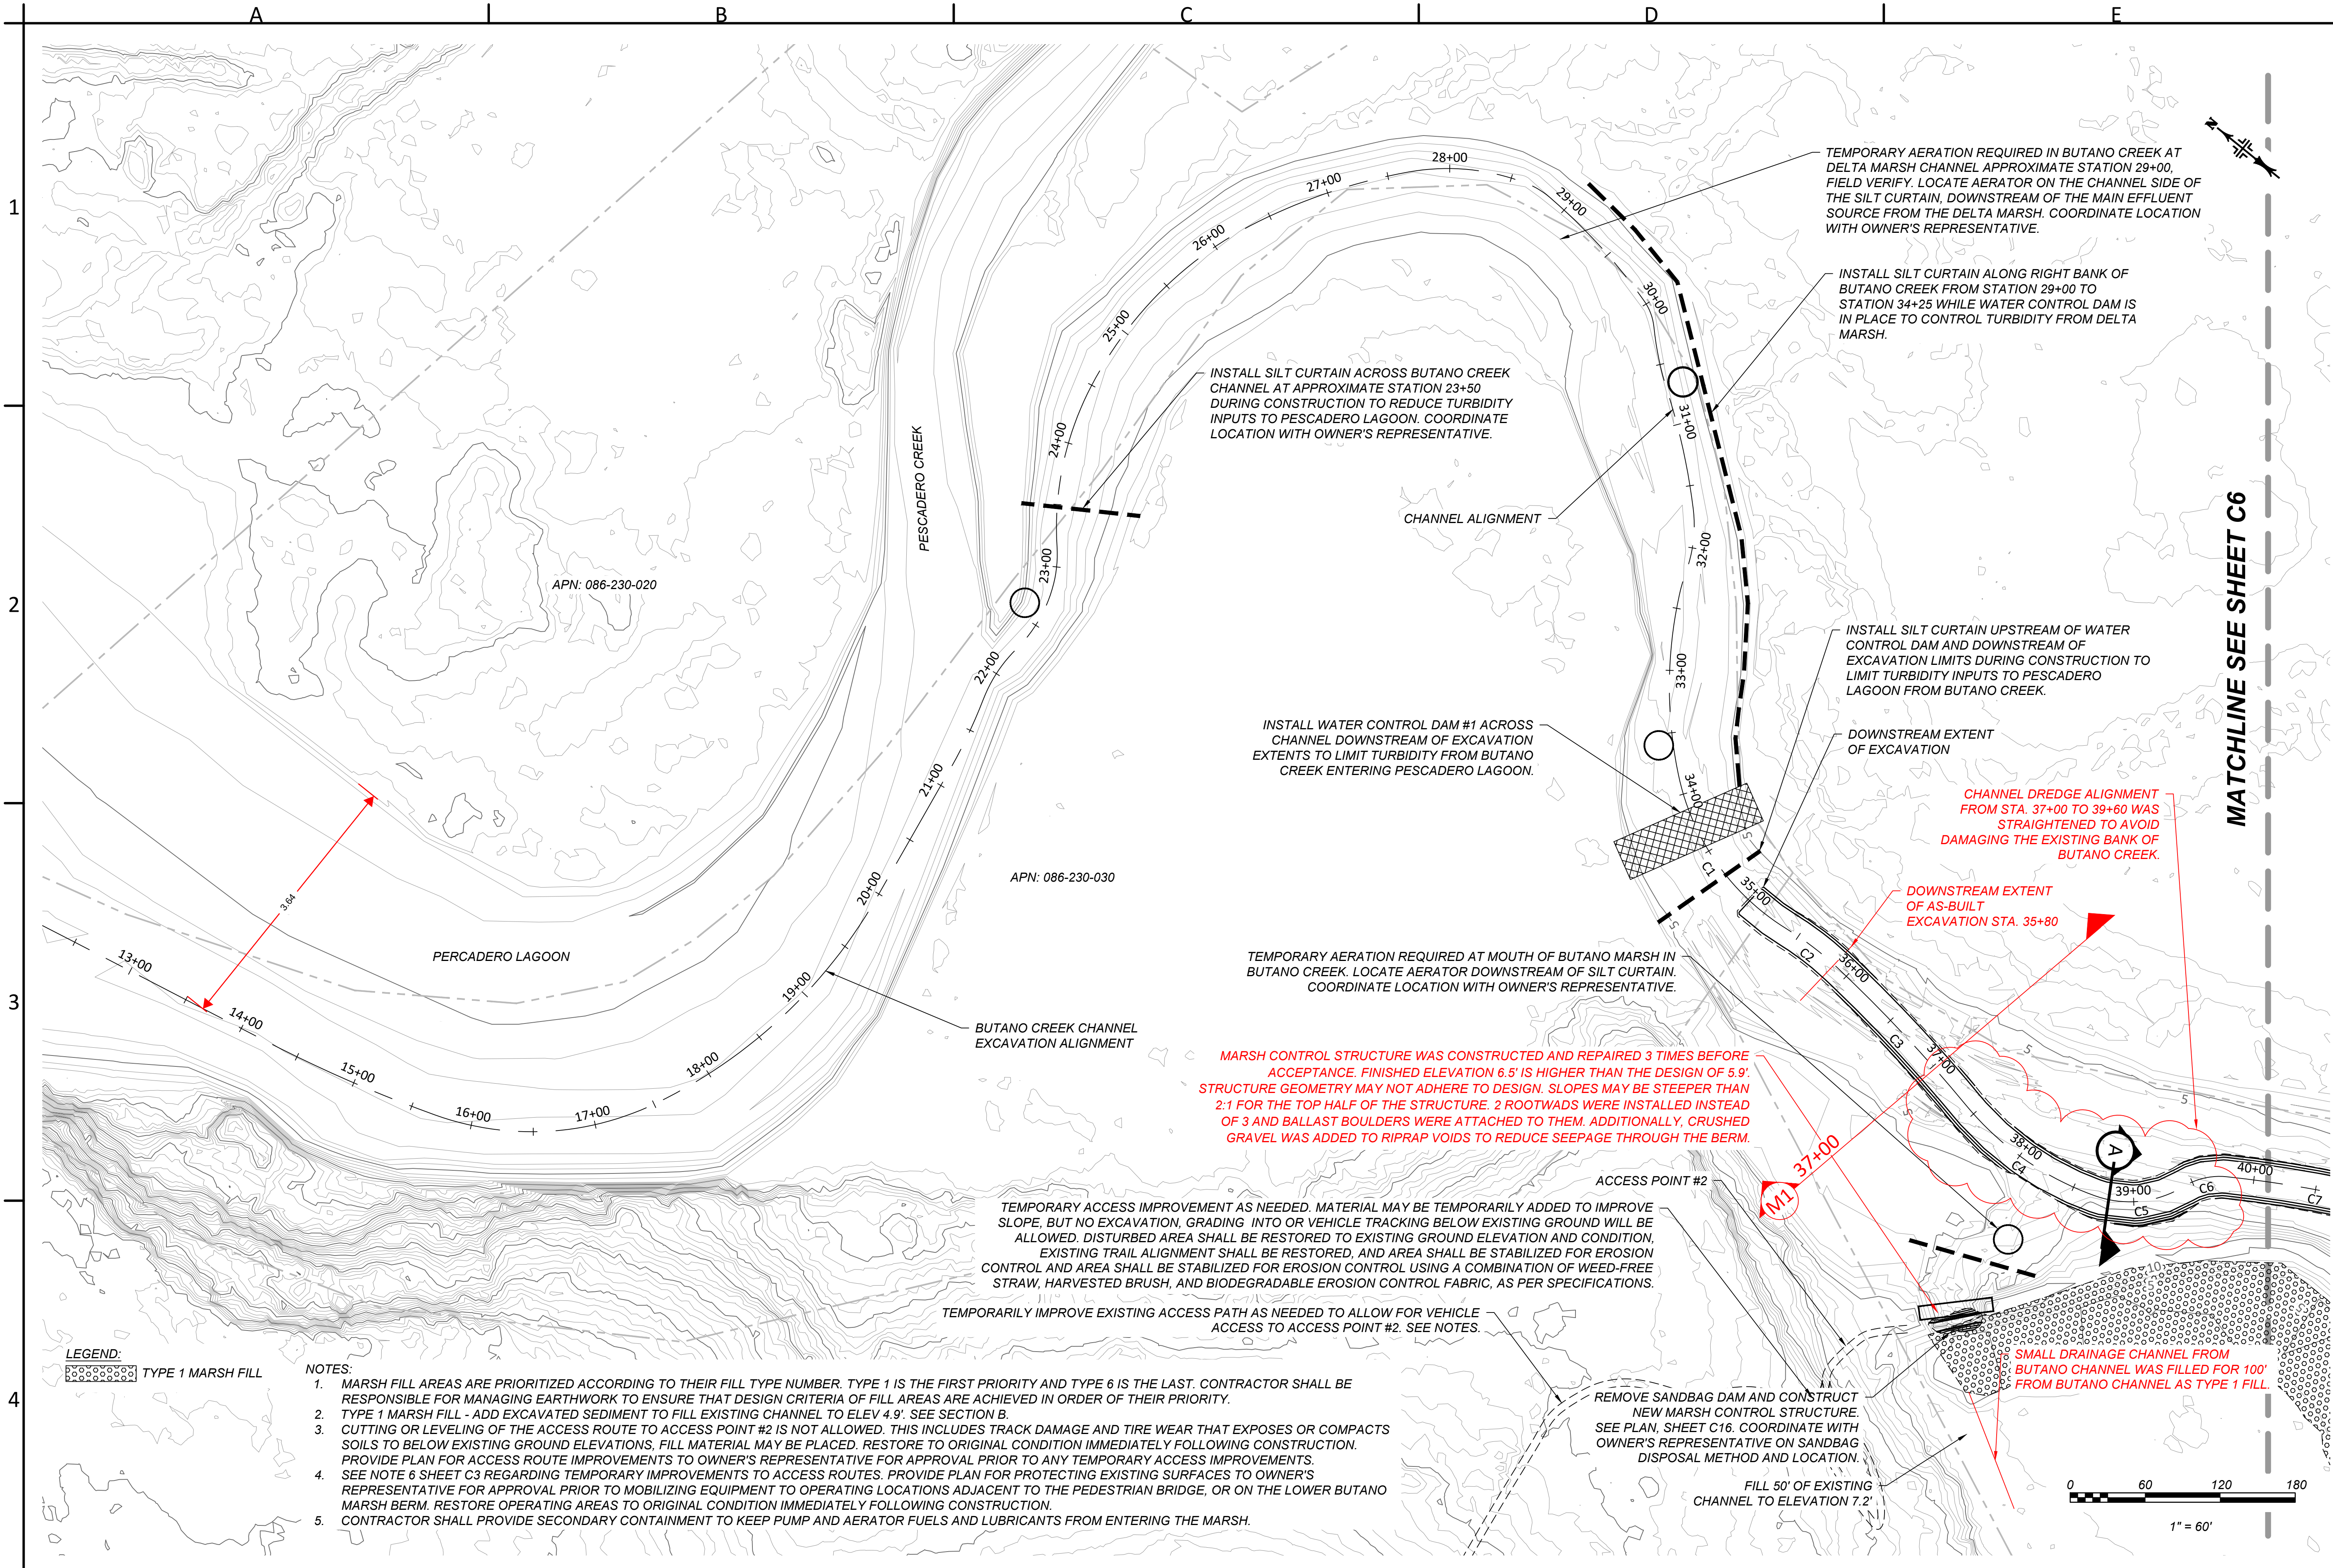

LEGEND:
[Symbol] TYPE 1 MARSH FILL

- NOTES:**
- MARSH FILL AREAS ARE PRIORITIZED ACCORDING TO THEIR FILL TYPE NUMBER. TYPE 1 IS THE FIRST PRIORITY AND TYPE 6 IS THE LAST. CONTRACTOR SHALL BE RESPONSIBLE FOR MANAGING EARTHWORK TO ENSURE THAT DESIGN CRITERIA OF FILL AREAS ARE ACHIEVED IN ORDER OF THEIR PRIORITY.
 - TYPE 1 MARSH FILL - ADD EXCAVATED SEDIMENT TO FILL EXISTING CHANNEL TO ELEV 4.9'. SEE SECTION B.
 - CUTTING OR LEVELING OF THE ACCESS ROUTE TO ACCESS POINT #2 IS NOT ALLOWED. THIS INCLUDES TRACK DAMAGE AND TIRE WEAR THAT EXPOSES OR COMPACTS SOILS TO BELOW EXISTING GROUND ELEVATIONS, FILL MATERIAL MAY BE PLACED. RESTORE TO ORIGINAL CONDITION IMMEDIATELY FOLLOWING CONSTRUCTION. PROVIDE PLAN FOR ACCESS ROUTE IMPROVEMENTS TO OWNER'S REPRESENTATIVE FOR APPROVAL PRIOR TO ANY TEMPORARY ACCESS IMPROVEMENTS.
 - SEE NOTE 6 SHEET C3 REGARDING TEMPORARY IMPROVEMENTS TO ACCESS ROUTES. PROVIDE PLAN FOR PROTECTING EXISTING SURFACES TO OWNER'S REPRESENTATIVE FOR APPROVAL PRIOR TO MOBILIZING EQUIPMENT TO OPERATING LOCATIONS ADJACENT TO THE PEDESTRIAN BRIDGE, OR ON THE LOWER BUTANO MARSH BERM. RESTORE OPERATING AREAS TO ORIGINAL CONDITION IMMEDIATELY FOLLOWING CONSTRUCTION.
 - CONTRACTOR SHALL PROVIDE SECONDARY CONTAINMENT TO KEEP PUMP AND AERATOR FUELS AND LUBRICANTS FROM ENTERING THE MARSH.

USE OF DOCUMENTS
THIS DOCUMENT, INCLUDING
THE INCORPORATED
DESIGN, SHALL NOT BE
USED FOR ANY OTHER
PROJECT AND SHALL NOT BE
REPRODUCED WITHOUT THE
WRITTEN AUTHORIZATION
OF cbec, inc.

DOCUMENT RELEASE		AS-BUILT	
DESIGNED	CH/JS/SD	DRAWN	JP/JM
REVIEWED	SD	APPROVED	CH

PREPARED BY:



cbec
eco engineering

CLIENT:

SAN MATEO
RESOURCE CONSERVATION DISTRICT
80 STONE PINE ROAD #100
HALF MOON BAY, CA 94019
(650) 712-7765


SAN MATEO
RESOURCE
CONSERVATION
DISTRICT

PESCADERO
BUTANO CREEK CHANNEL RECONNECTION
AND RESILIENCE PROJECT
PLAN VIEW (1 OF 7)

JOB NUMBER
16-1027-4

DATE
FEB 2020

SHEET
C5
5 OF 19

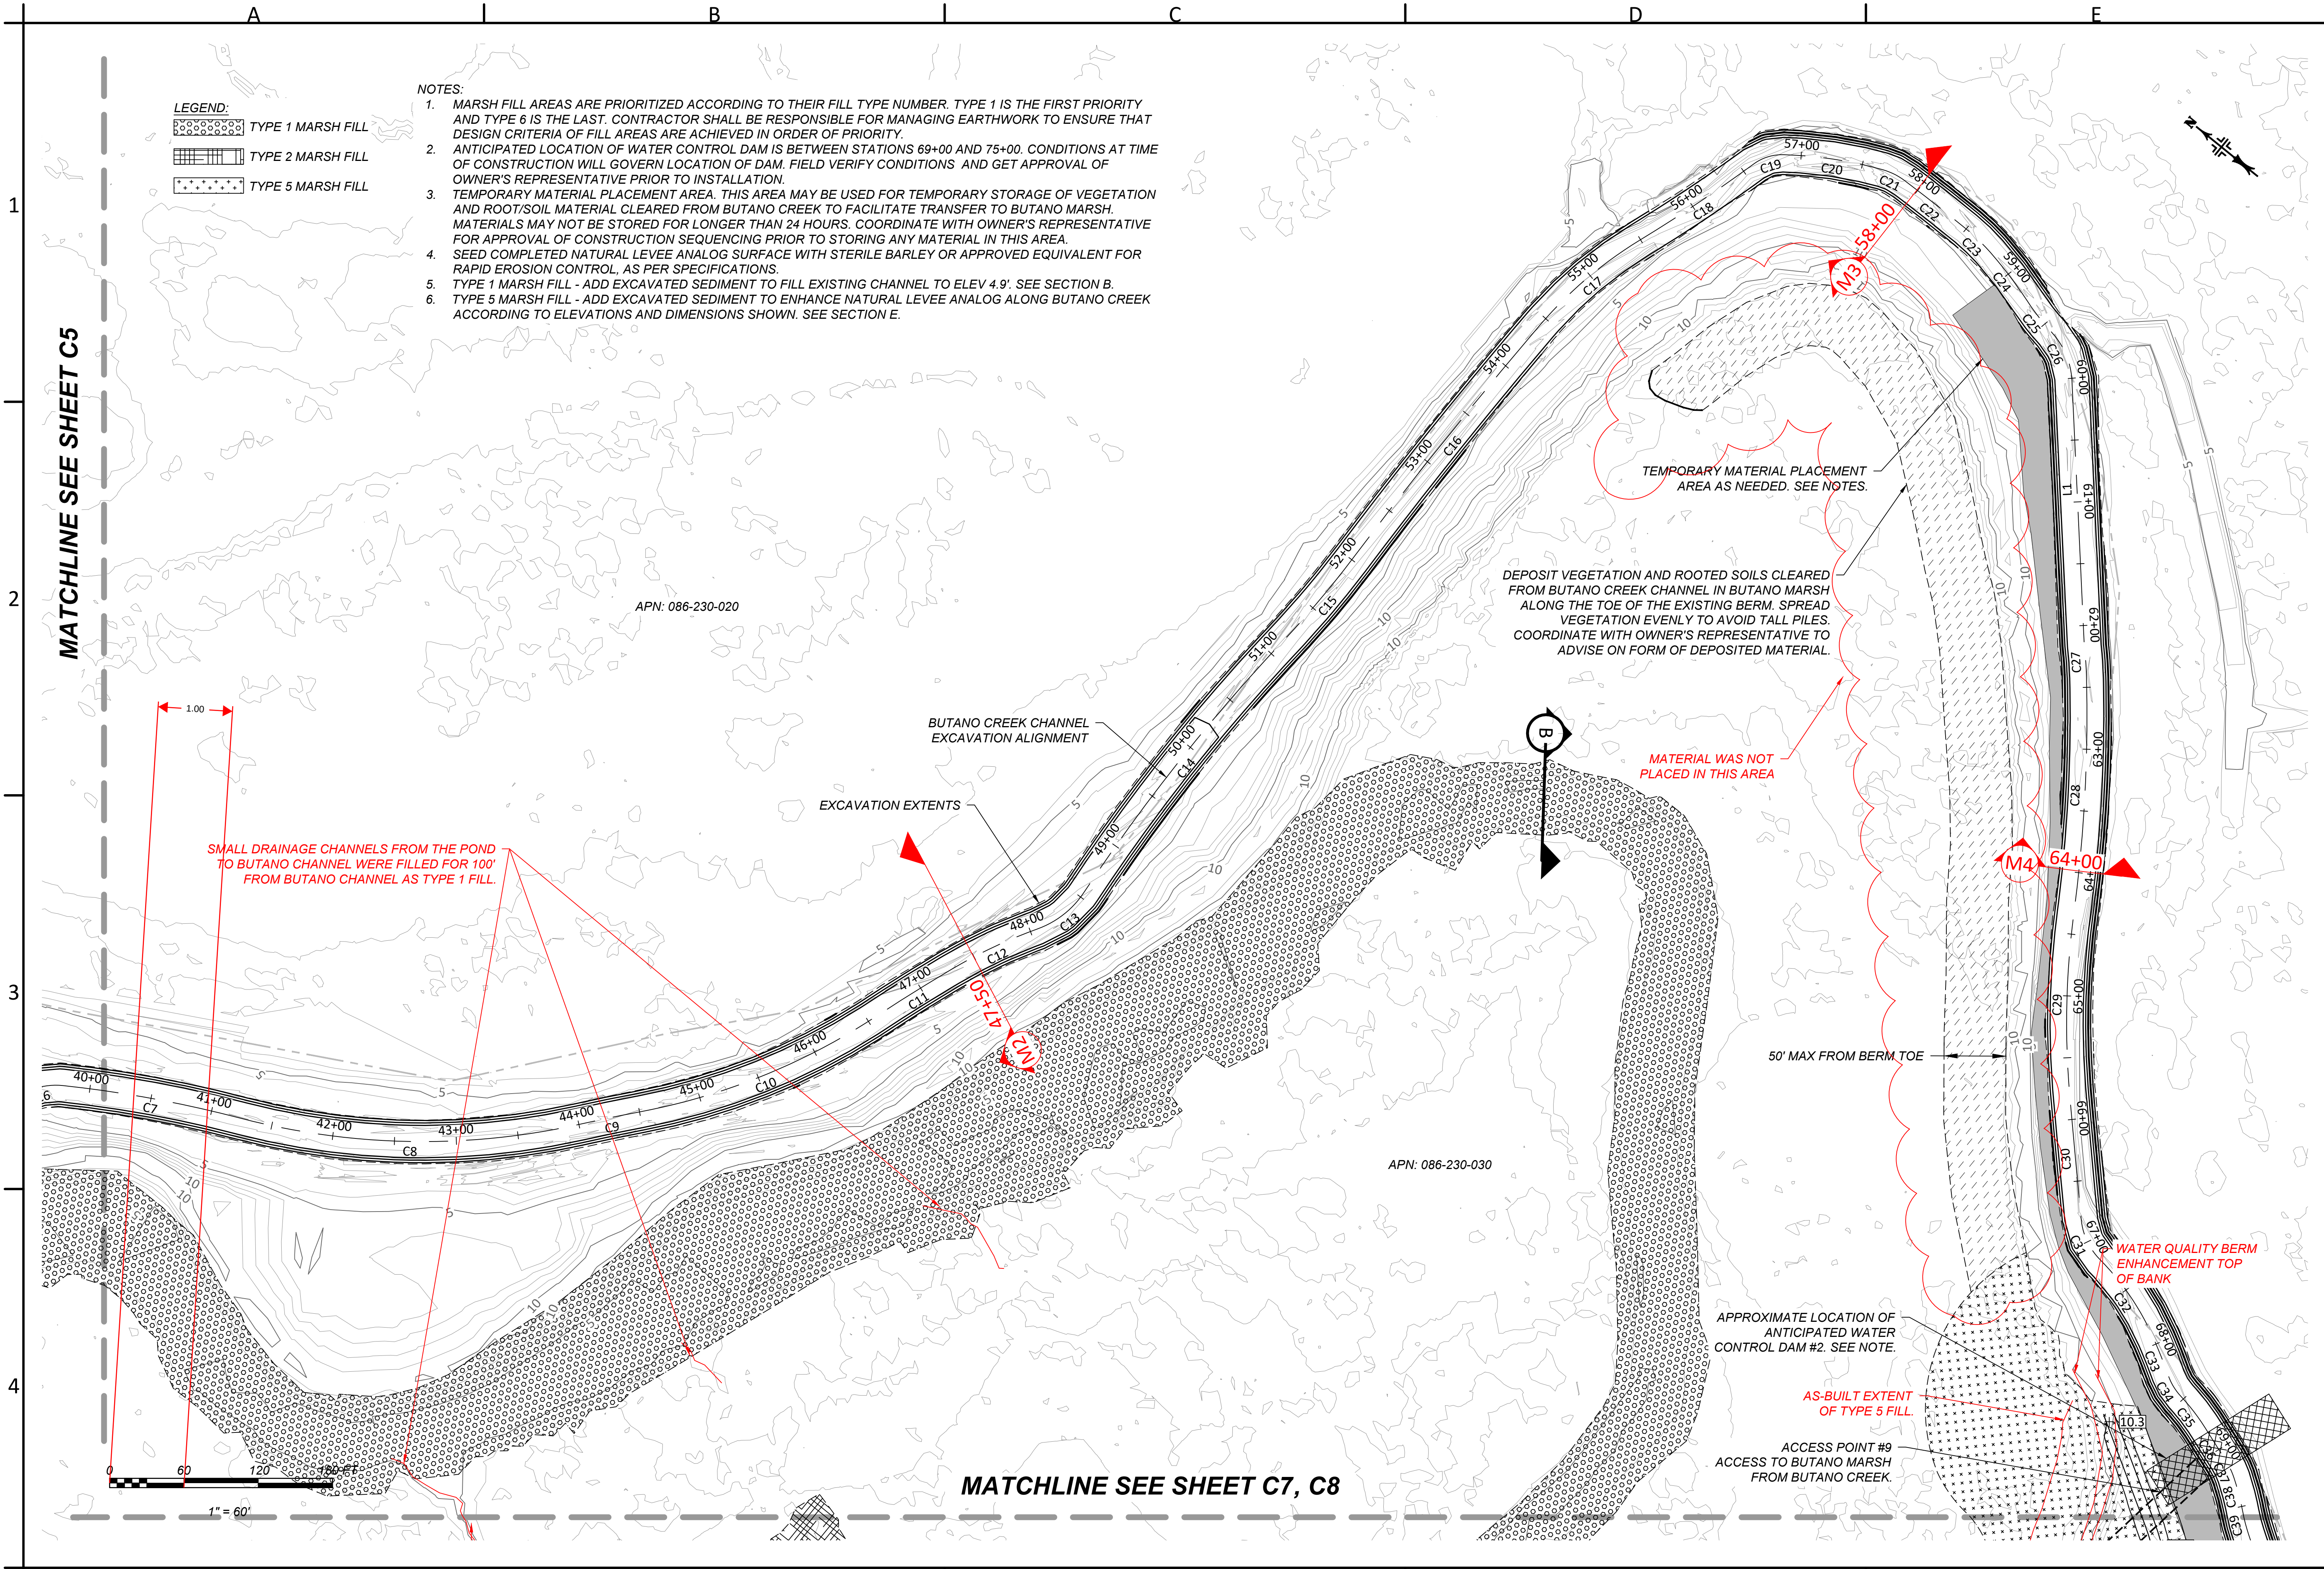

LEGEND:

- TYPE 1 MARSH FILL
- TYPE 2 MARSH FILL
- TYPE 5 MARSH FILL

NOTES:

- MARSH FILL AREAS ARE PRIORITIZED ACCORDING TO THEIR FILL TYPE NUMBER. TYPE 1 IS THE FIRST PRIORITY AND TYPE 6 IS THE LAST. CONTRACTOR SHALL BE RESPONSIBLE FOR MANAGING EARTHWORK TO ENSURE THAT DESIGN CRITERIA OF FILL AREAS ARE ACHIEVED IN ORDER OF PRIORITY.
- ANTICIPATED LOCATION OF WATER CONTROL DAM IS BETWEEN STATIONS 69+00 AND 75+00. CONDITIONS AT TIME OF CONSTRUCTION WILL GOVERN LOCATION OF DAM. FIELD VERIFY CONDITIONS AND GET APPROVAL OF OWNER'S REPRESENTATIVE PRIOR TO INSTALLATION.
- TEMPORARY MATERIAL PLACEMENT AREA. THIS AREA MAY BE USED FOR TEMPORARY STORAGE OF VEGETATION AND ROOT/SOIL MATERIAL CLEARED FROM BUTANO CREEK TO FACILITATE TRANSFER TO BUTANO MARSH. MATERIALS MAY NOT BE STORED FOR LONGER THAN 24 HOURS. COORDINATE WITH OWNER'S REPRESENTATIVE FOR APPROVAL OF CONSTRUCTION SEQUENCING PRIOR TO STORING ANY MATERIAL IN THIS AREA.
- SEED COMPLETED NATURAL LEVEE ANALOG SURFACE WITH STERILE BARLEY OR APPROVED EQUIVALENT FOR RAPID EROSION CONTROL, AS PER SPECIFICATIONS.
- TYPE 1 MARSH FILL - ADD EXCAVATED SEDIMENT TO FILL EXISTING CHANNEL TO ELEV 4.9'. SEE SECTION B.
- TYPE 5 MARSH FILL - ADD EXCAVATED SEDIMENT TO ENHANCE NATURAL LEVEE ANALOG ALONG BUTANO CREEK ACCORDING TO ELEVATIONS AND DIMENSIONS SHOWN. SEE SECTION E.

APN: 086-230-020

BUTANO CREEK CHANNEL
EXCAVATION ALIGNMENT

EXCAVATION EXTENTS

SMALL DRAINAGE CHANNELS FROM THE POND
TO BUTANO CHANNEL WERE FILLED FOR 100'
FROM BUTANO CHANNEL AS TYPE 1 FILL.

DEPOSIT VEGETATION AND ROOTED SOILS CLEARED
FROM BUTANO CREEK CHANNEL IN BUTANO MARSH
ALONG THE TOE OF THE EXISTING BERM. SPREAD
VEGETATION EVENLY TO AVOID TALL PILES.
COORDINATE WITH OWNER'S REPRESENTATIVE TO
ADVISE ON FORM OF DEPOSITED MATERIAL.

MATERIAL WAS NOT
PLACED IN THIS AREA

50' MAX FROM BERM TOE

WATER QUALITY BERM
ENHANCEMENT TOP
OF BANK

APPROXIMATE LOCATION OF
ANTICIPATED WATER
CONTROL DAM #2. SEE NOTE.


AS-BUILT EXTENT
OF TYPE 5 FILL.

ACCESS POINT #9
ACCESS TO BUTANO MARSH
FROM BUTANO CREEK.

MATCHLINE SEE SHEET C7, C8

MATCHLINE SEE SHEET C5

USE OF DOCUMENTS THIS DOCUMENT, INCLUDING THE INCORPORATED DESIGN, SHALL NOT BE USED FOR ANY OTHER PROJECT AND SHALL NOT BE REPRODUCED OR TRANSMITTED IN ANY FORM OR BY ANY MEANS, ELECTRONIC OR MECHANICAL, INCLUDING PHOTOCOPYING, RECORDING, OR BY ANY INFORMATION SYSTEM, WITHOUT THE WRITTEN AUTHORIZATION OF cbec, inc.	DOCUMENT RELEASE AS-BUILT	DESIGNED CH/JS/SD	DRAWN JP/JM	REVIEWED SD	APPROVED CH	PREPARED BY:  c b e c eco engineering	CLIENT: CALIFORNIA SAN MATEO RESOURCE CONSERVATION DISTRICT 80 STONE PINE ROAD #100 HALF MOON BAY, CA 94019 (650) 712-7765	PESCADERO BUTANO CREEK CHANNEL RECONNECTION AND RESILIENCE PROJECT PLAN VIEW (2 OF 7)	JOB NUMBER 16-1027-4
									DATE FEB 2020
SHEET C6 6 OF 19									

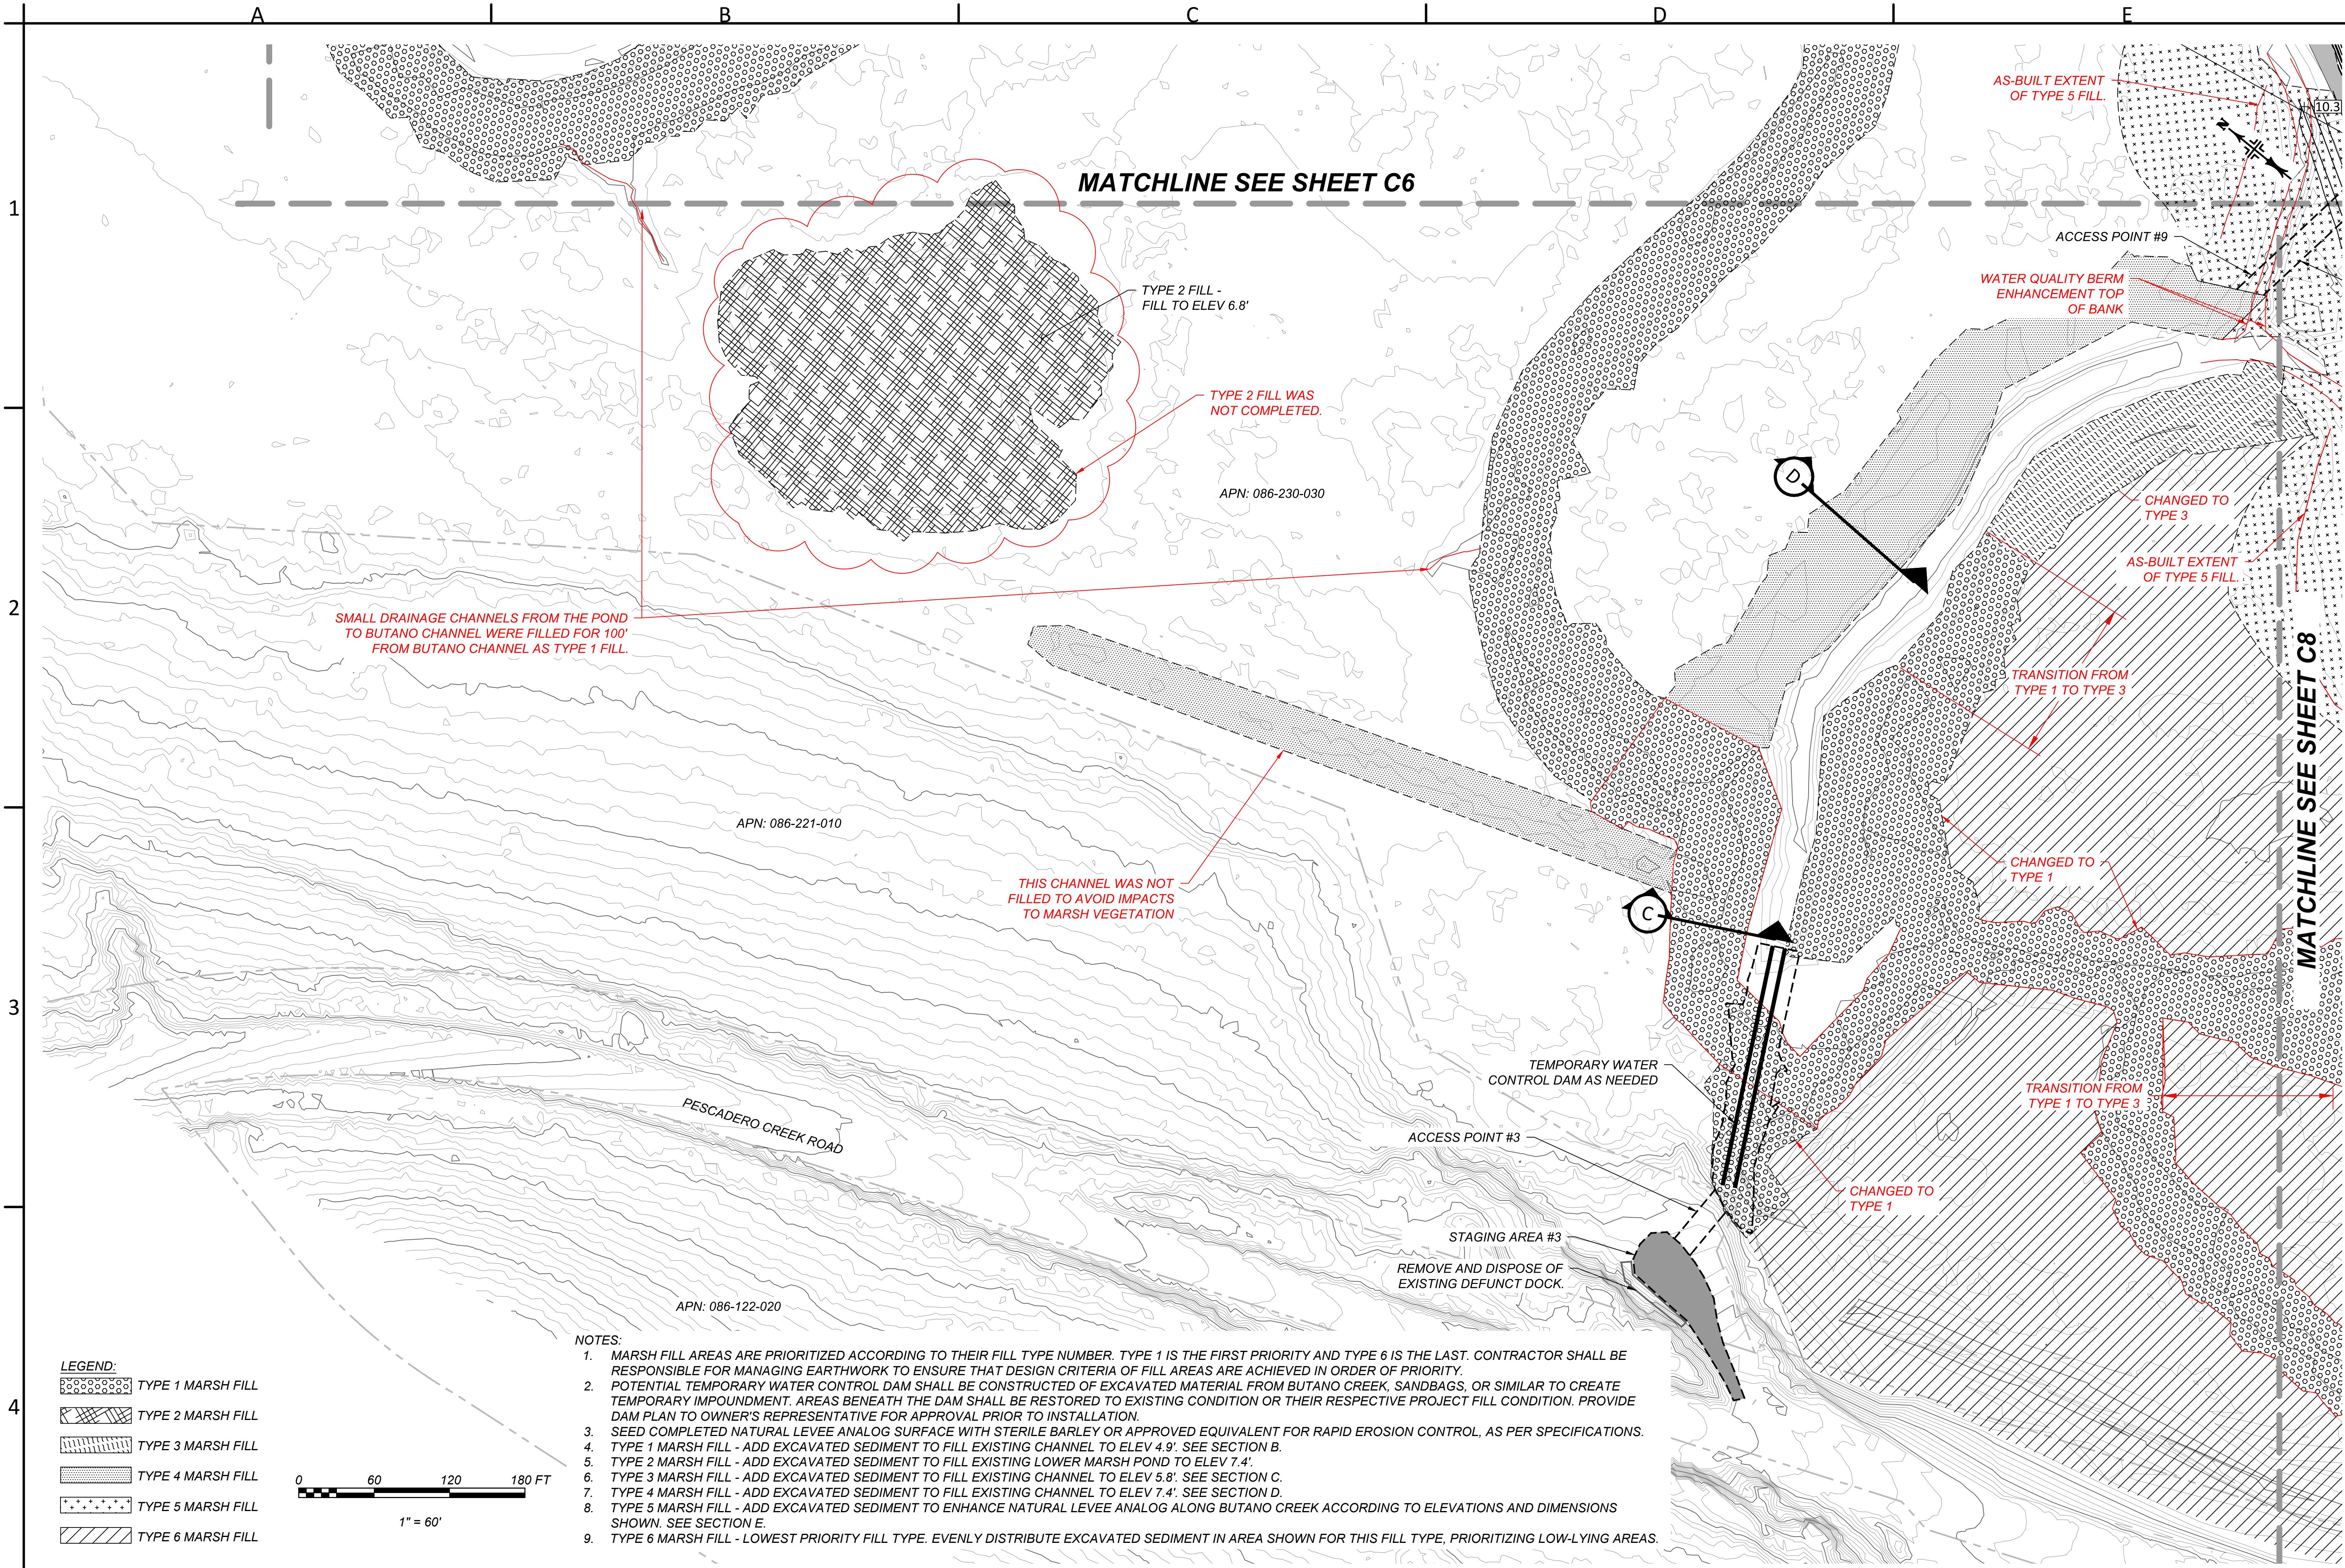

LEGEND:

TYPE 1 MARSH FILL

TYPE 2 MARSH FILL

TYPE 3 MARSH FILL

TYPE 4 MARSH FILL

TYPE 5 MARSH FILL

TYPE 6 MARSH FILL

0 60 120 180 FT

1" = 60'

- NOTES:
- MARSH FILL AREAS ARE PRIORITIZED ACCORDING TO THEIR FILL TYPE NUMBER. TYPE 1 IS THE FIRST PRIORITY AND TYPE 6 IS THE LAST. CONTRACTOR SHALL BE RESPONSIBLE FOR MANAGING EARTHWORK TO ENSURE THAT DESIGN CRITERIA OF FILL AREAS ARE ACHIEVED IN ORDER OF PRIORITY.
 - POTENTIAL TEMPORARY WATER CONTROL DAM SHALL BE CONSTRUCTED OF EXCAVATED MATERIAL FROM BUTANO CREEK, SANDBAGS, OR SIMILAR TO CREATE TEMPORARY IMPOUNDMENT. AREAS BENEATH THE DAM SHALL BE RESTORED TO EXISTING CONDITION OR THEIR RESPECTIVE PROJECT FILL CONDITION. PROVIDE DAM PLAN TO OWNER'S REPRESENTATIVE FOR APPROVAL PRIOR TO INSTALLATION.
 - SEED COMPLETED NATURAL LEVEE ANALOG SURFACE WITH STERILE BARLEY OR APPROVED EQUIVALENT FOR RAPID EROSION CONTROL, AS PER SPECIFICATIONS.
 - TYPE 1 MARSH FILL - ADD EXCAVATED SEDIMENT TO FILL EXISTING CHANNEL TO ELEV 4.9'. SEE SECTION B.
 - TYPE 2 MARSH FILL - ADD EXCAVATED SEDIMENT TO FILL EXISTING LOWER MARSH POND TO ELEV 7.4'.
 - TYPE 3 MARSH FILL - ADD EXCAVATED SEDIMENT TO FILL EXISTING CHANNEL TO ELEV 5.8'. SEE SECTION C.
 - TYPE 4 MARSH FILL - ADD EXCAVATED SEDIMENT TO FILL EXISTING CHANNEL TO ELEV 7.4'. SEE SECTION D.
 - TYPE 5 MARSH FILL - ADD EXCAVATED SEDIMENT TO ENHANCE NATURAL LEVEE ANALOG ALONG BUTANO CREEK ACCORDING TO ELEVATIONS AND DIMENSIONS SHOWN. SEE SECTION E.
 - TYPE 6 MARSH FILL - LOWEST PRIORITY FILL TYPE. EVENLY DISTRIBUTE EXCAVATED SEDIMENT IN AREA SHOWN FOR THIS FILL TYPE, PRIORITIZING LOW-LYING AREAS.

USE OF DOCUMENTS
THIS DOCUMENT, INCLUDING
THE INCORPORATED
DESIGN, SHALL BE THE
PROPERTY OF THE
PROJECT AND SHALL NOT BE
USED FOR ANY OTHER
PROJECT WITHOUT THE
WRITTEN AUTHORIZATION
OF cbec, inc.

DOCUMENT RELEASE	
DESIGNED	CH/JS/SD
DRAWN	JP/JM
REVIEWED	SD
APPROVED	CH

PREPARED BY:

cbec
eco engineering

CLIENT:

SAN MATEO
RESOURCE CONSERVATION DISTRICT
80 STONE PINE ROAD #100
HALF MOON BAY, CA 94019
(650) 712-7765

PESCADERO CALIFORNIA

**BUTANO CREEK CHANNEL RECONNECTION
AND RESILIENCE PROJECT**

PLAN VIEW (3 OF 7)

JOB NUMBER

16-1027-4

DATE

DEC 2019

SHEET


C7

7 OF 19


MATCHLINE SEE SHEET C6

MATCHLINE SEE SHEET C7

MATCHLINE SEE SHEET C9

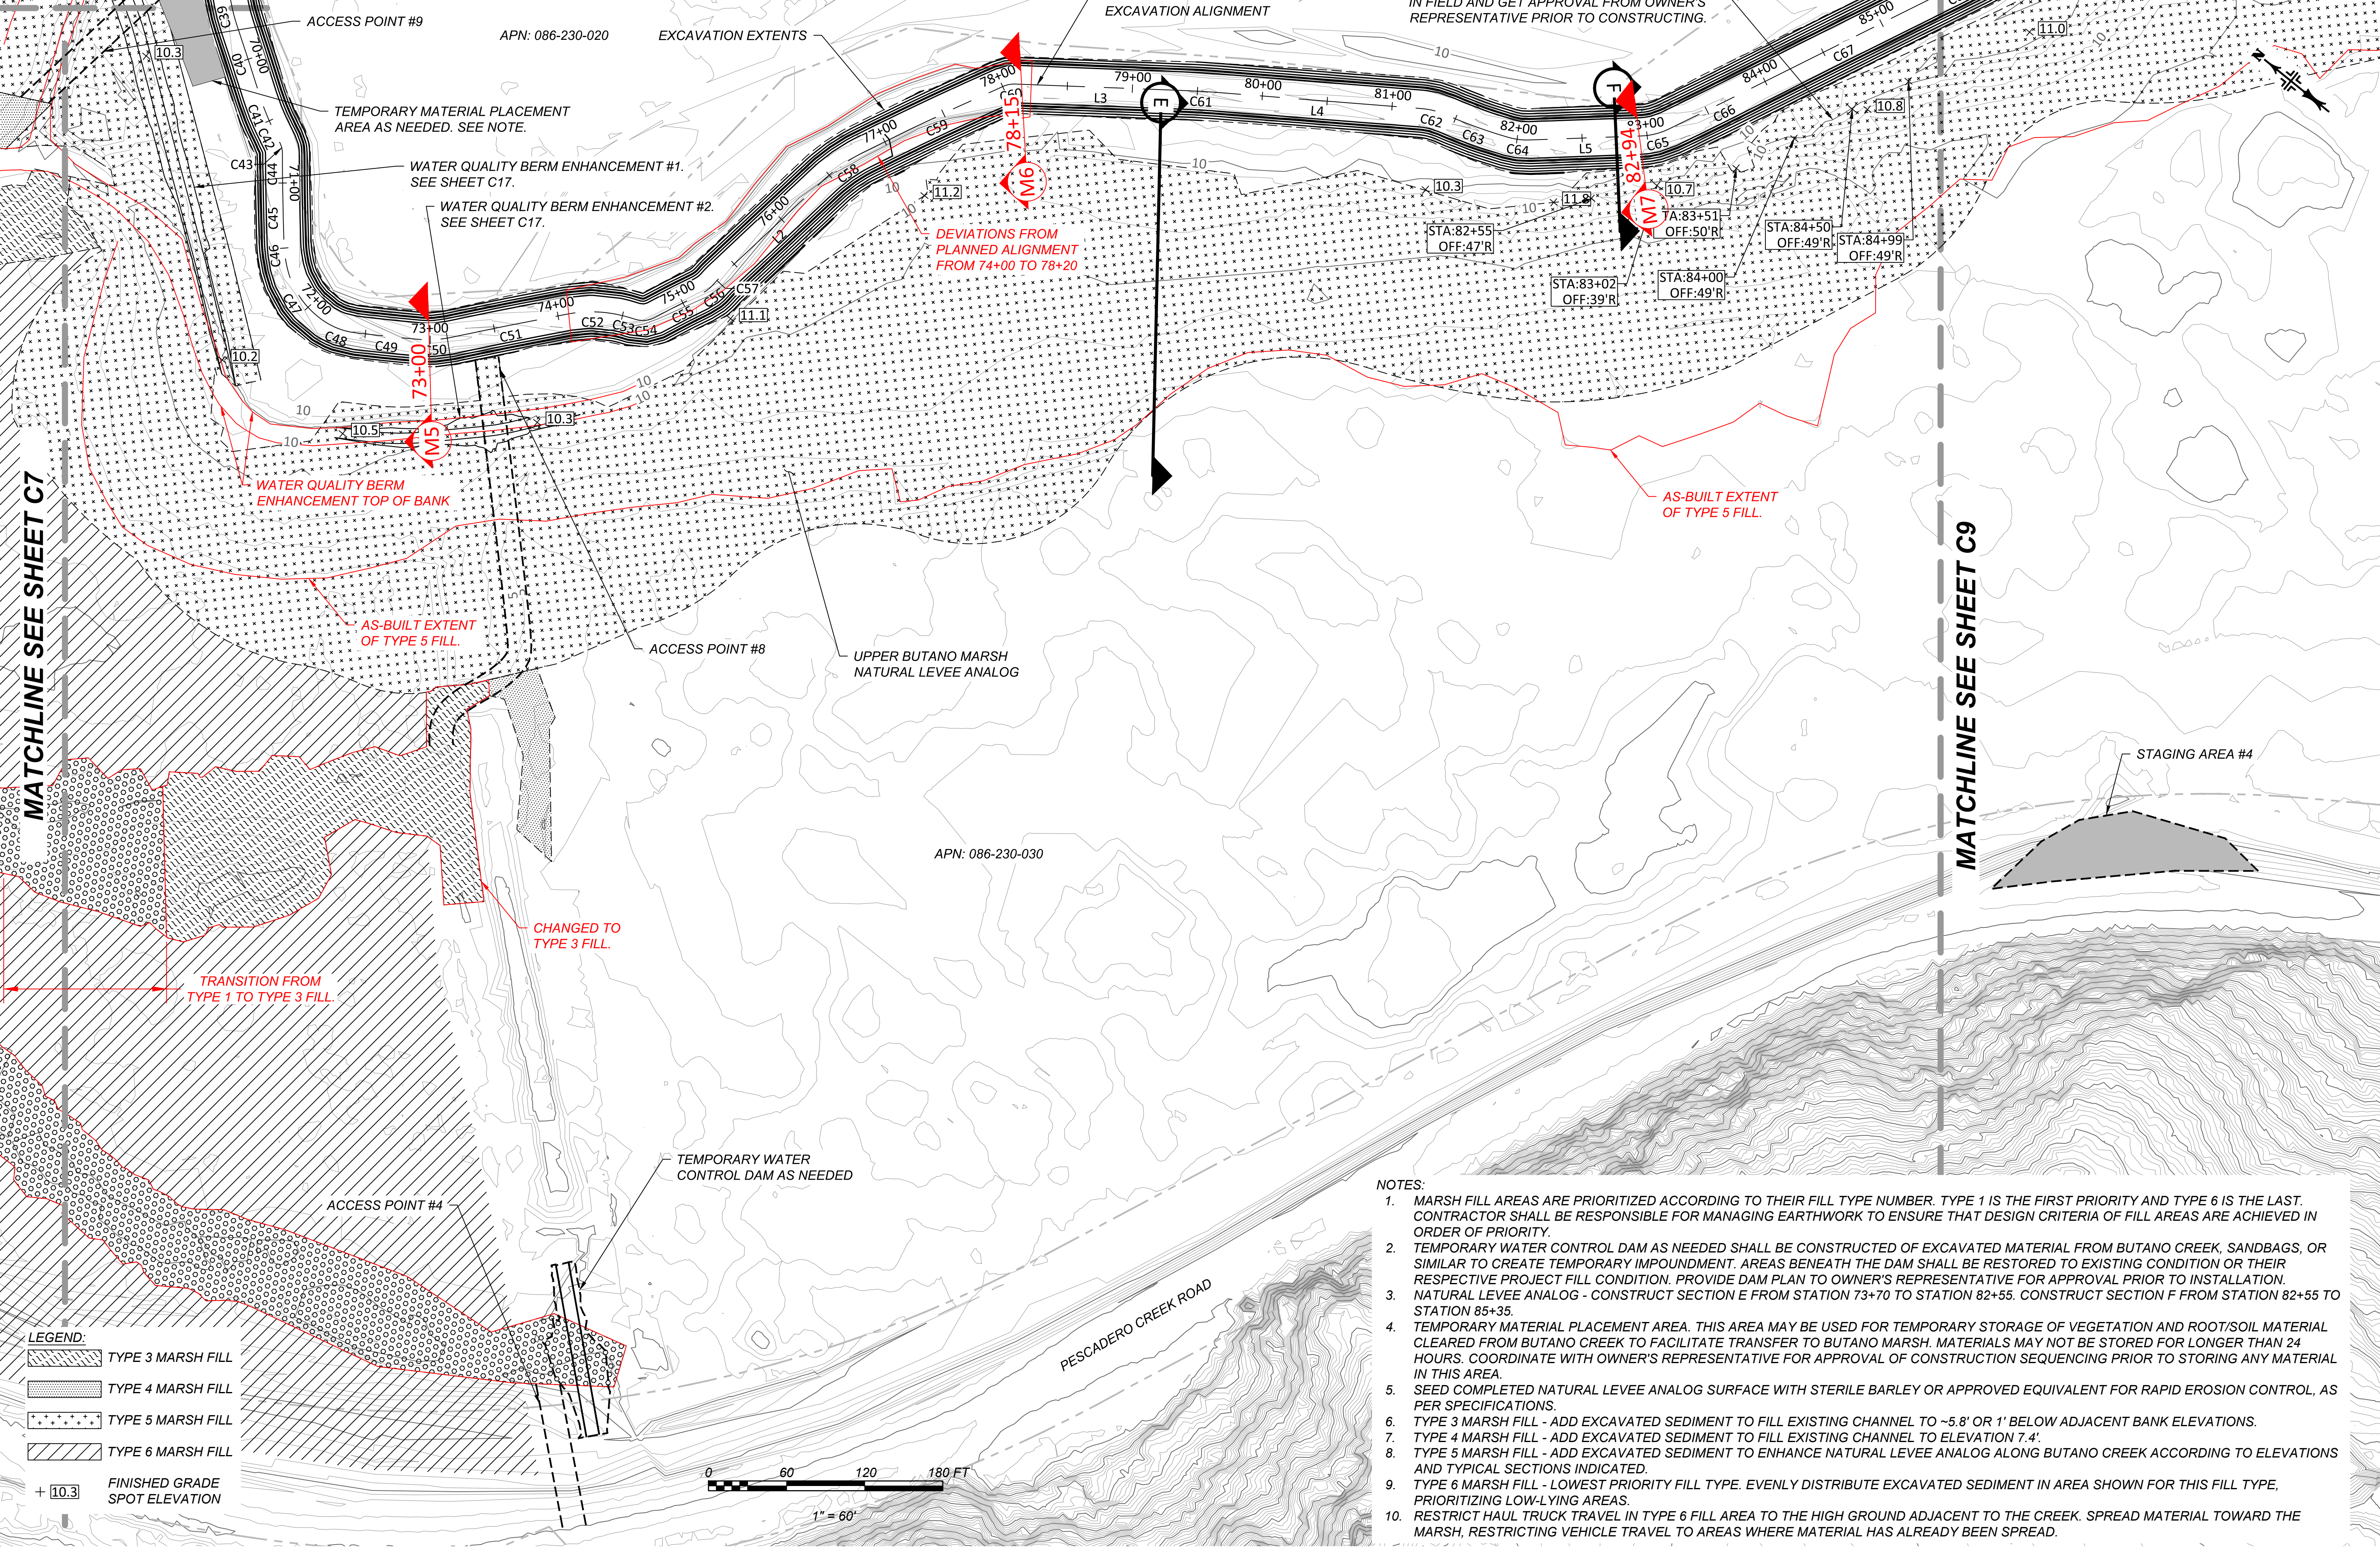

USE OF DOCUMENTS THIS DOCUMENT, INCLUDING THE INCORPORATED DESIGN, IS THE PROPERTY OF THE CONSULTANT. IT IS TO BE USED FOR THE PROJECT AND SHALL NOT BE REPRODUCED OR USED FOR ANY OTHER PROJECT WITHOUT THE WRITTEN AUTHORIZATION OF cbec, inc.	DOCUMENT RELEASE		AS-BUILT	
	DESIGNED	CH/S/SD	DRAWN	JP/JM
	REVIEWED	SD	APPROVED	CH
	REVISION NOTES			
PREPARED BY:	cbececo engineering			
	SAN MATEO RESOURCE CONSERVATION DISTRICT			
	80 STONE PINE ROAD #100			
	HALF MOON BAY, CA 94019 (650) 712-7765			
CLIENT:	CALIFORNIA			
	PESCADERO			
	BUTANO CREEK CHANNEL RECONNECTION AND RESILIENCE PROJECT			
	PLAN VIEW (4 OF 7)			
JOB NUMBER	16-1027-4			
	DATE			
	DEC 2019			
	SHEET			
C8				8 OF 19


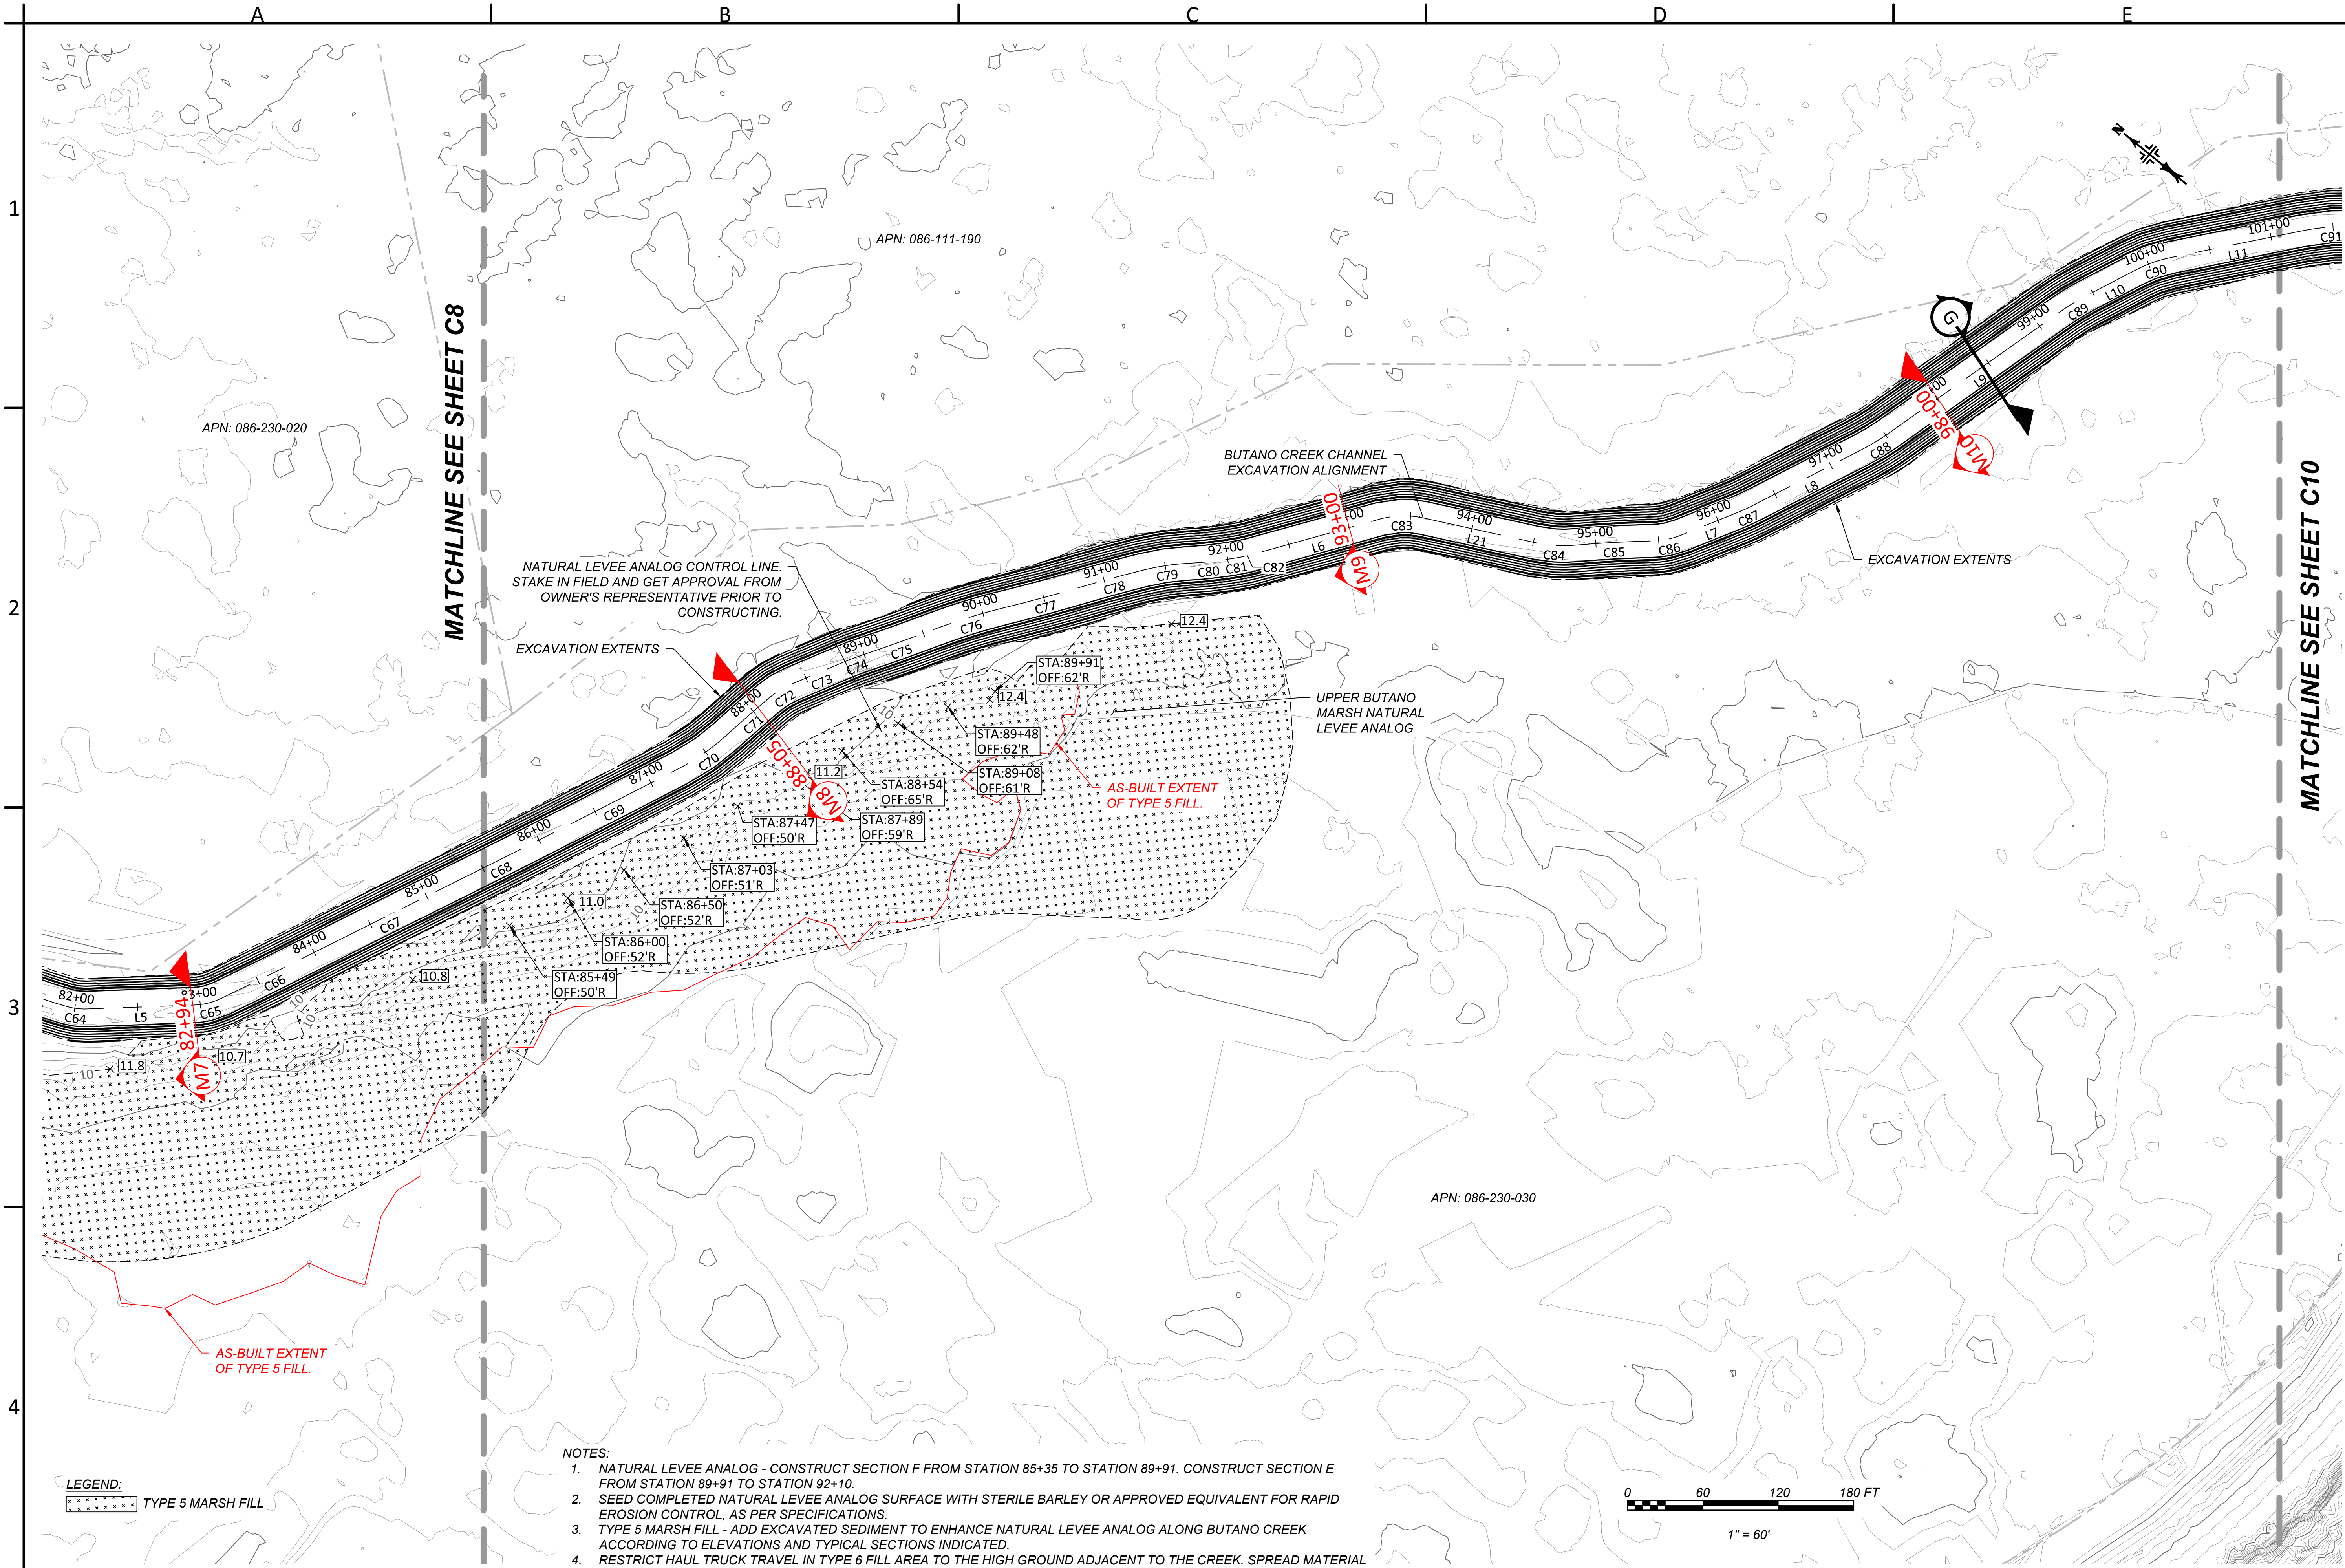


- NOTES:
1. NATURAL LEVEE ANALOG - CONSTRUCT SECTION F FROM STATION 85+35 TO STATION 89+91. CONSTRUCT SECTION E FROM STATION 89+91 TO STATION 92+10.
 2. SEED COMPLETED NATURAL LEVEE ANALOG SURFACE WITH STERILE BARLEY OR APPROVED EQUIVALENT FOR RAPID EROSION CONTROL, AS PER SPECIFICATIONS.
 3. TYPE 5 MARSH FILL - ADD EXCAVATED SEDIMENT TO ENHANCE NATURAL LEVEE ANALOG ALONG BUTANO CREEK ACCORDING TO ELEVATIONS AND TYPICAL SECTIONS INDICATED.
 4. RESTRICT HAUL TRUCK TRAVEL IN TYPE 6 FILL AREA TO THE HIGH GROUND ADJACENT TO THE CREEK. SPREAD MATERIAL TOWARD THE MARSH, RESTRICTING VEHICLE TRAVEL TO AREAS WHERE MATERIAL HAS ALREADY BEEN SPREAD.


LEGEND:

TYPE 5 MARSH FILL


PESCADERO	CALIFORNIA	CLIENT:	SAN MATEO RESOURCE CONSERVATION DISTRICT 80 STONE PINE ROAD #100 HALF MOON BAY, CA 94019 (650) 712-7765	PREPARED BY:		USE OF DOCUMENTS THIS DOCUMENT, INCLUDING THE INCORPORATED DESIGN, SHALL NOT BE USED FOR ANY OTHER PROJECT OR FOR ANY OTHER PURPOSE WITHOUT THE WRITTEN AUTHORIZATION OF cbec, inc.	DESIGNED	CH/JIS/SD	DOCUMENT RELEASE	AS-BUILT
							DRAWN	JP/JM	REVISION NOTES	
							REVIEWED	SD		
							APPROVED	CH		
BUTANO CREEK CHANNEL RECONNECTION AND RESILIENCE PROJECT							JOB NUMBER		16-1027-4	
							DATE		DEC 2019	
							SHEET		C9	
									9 OF 19	

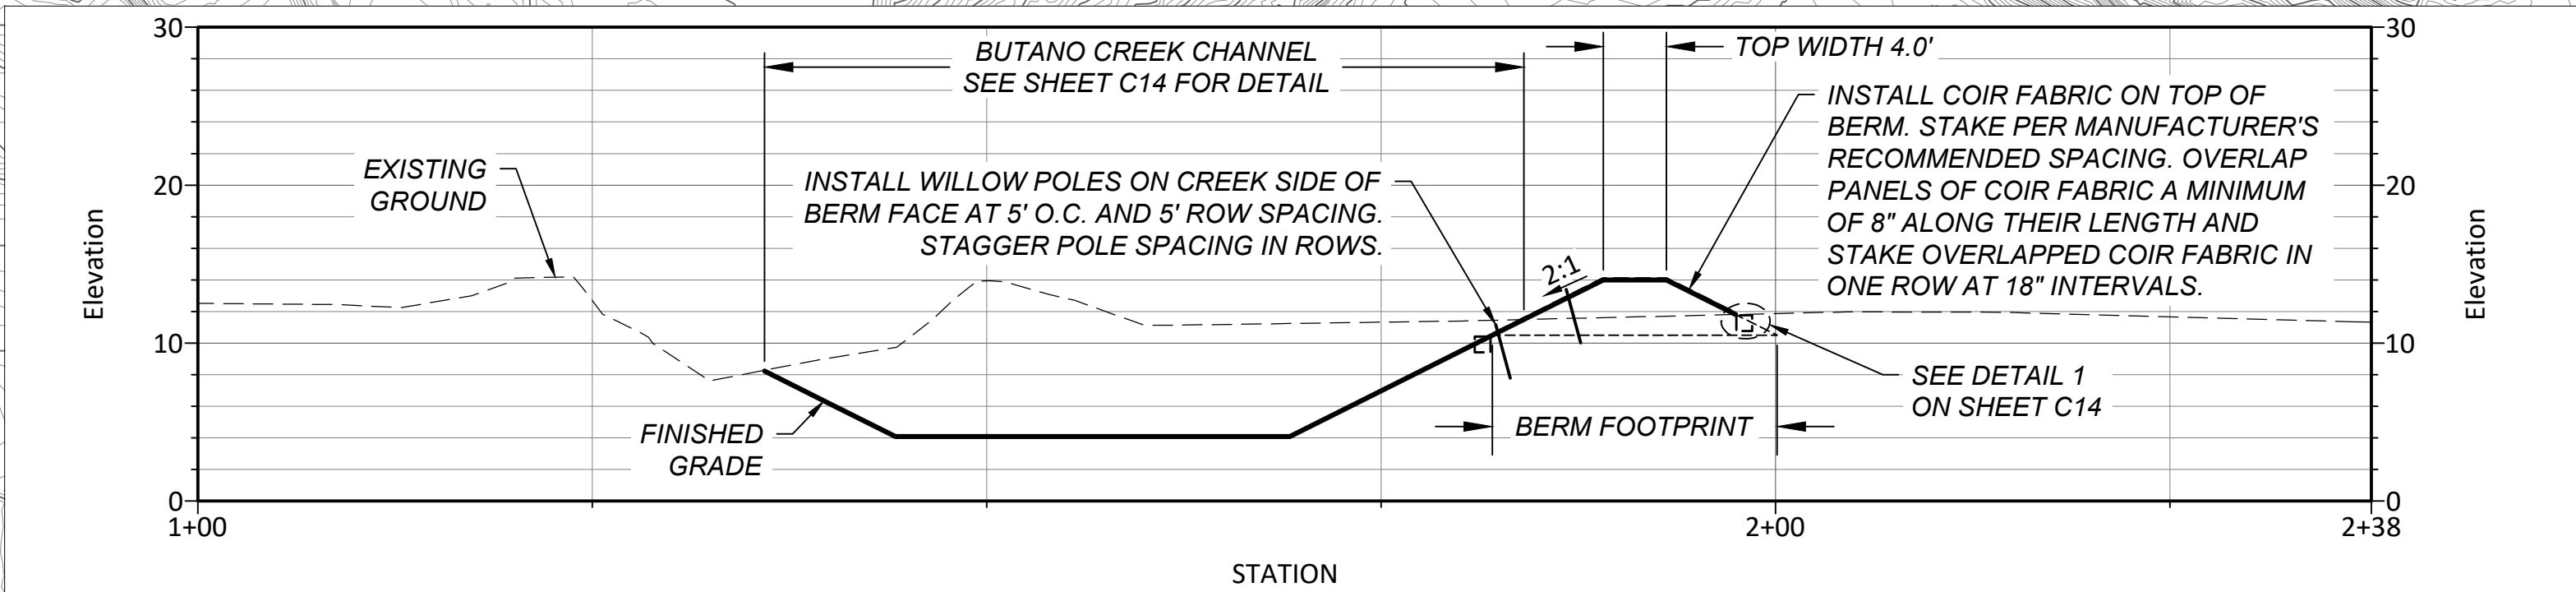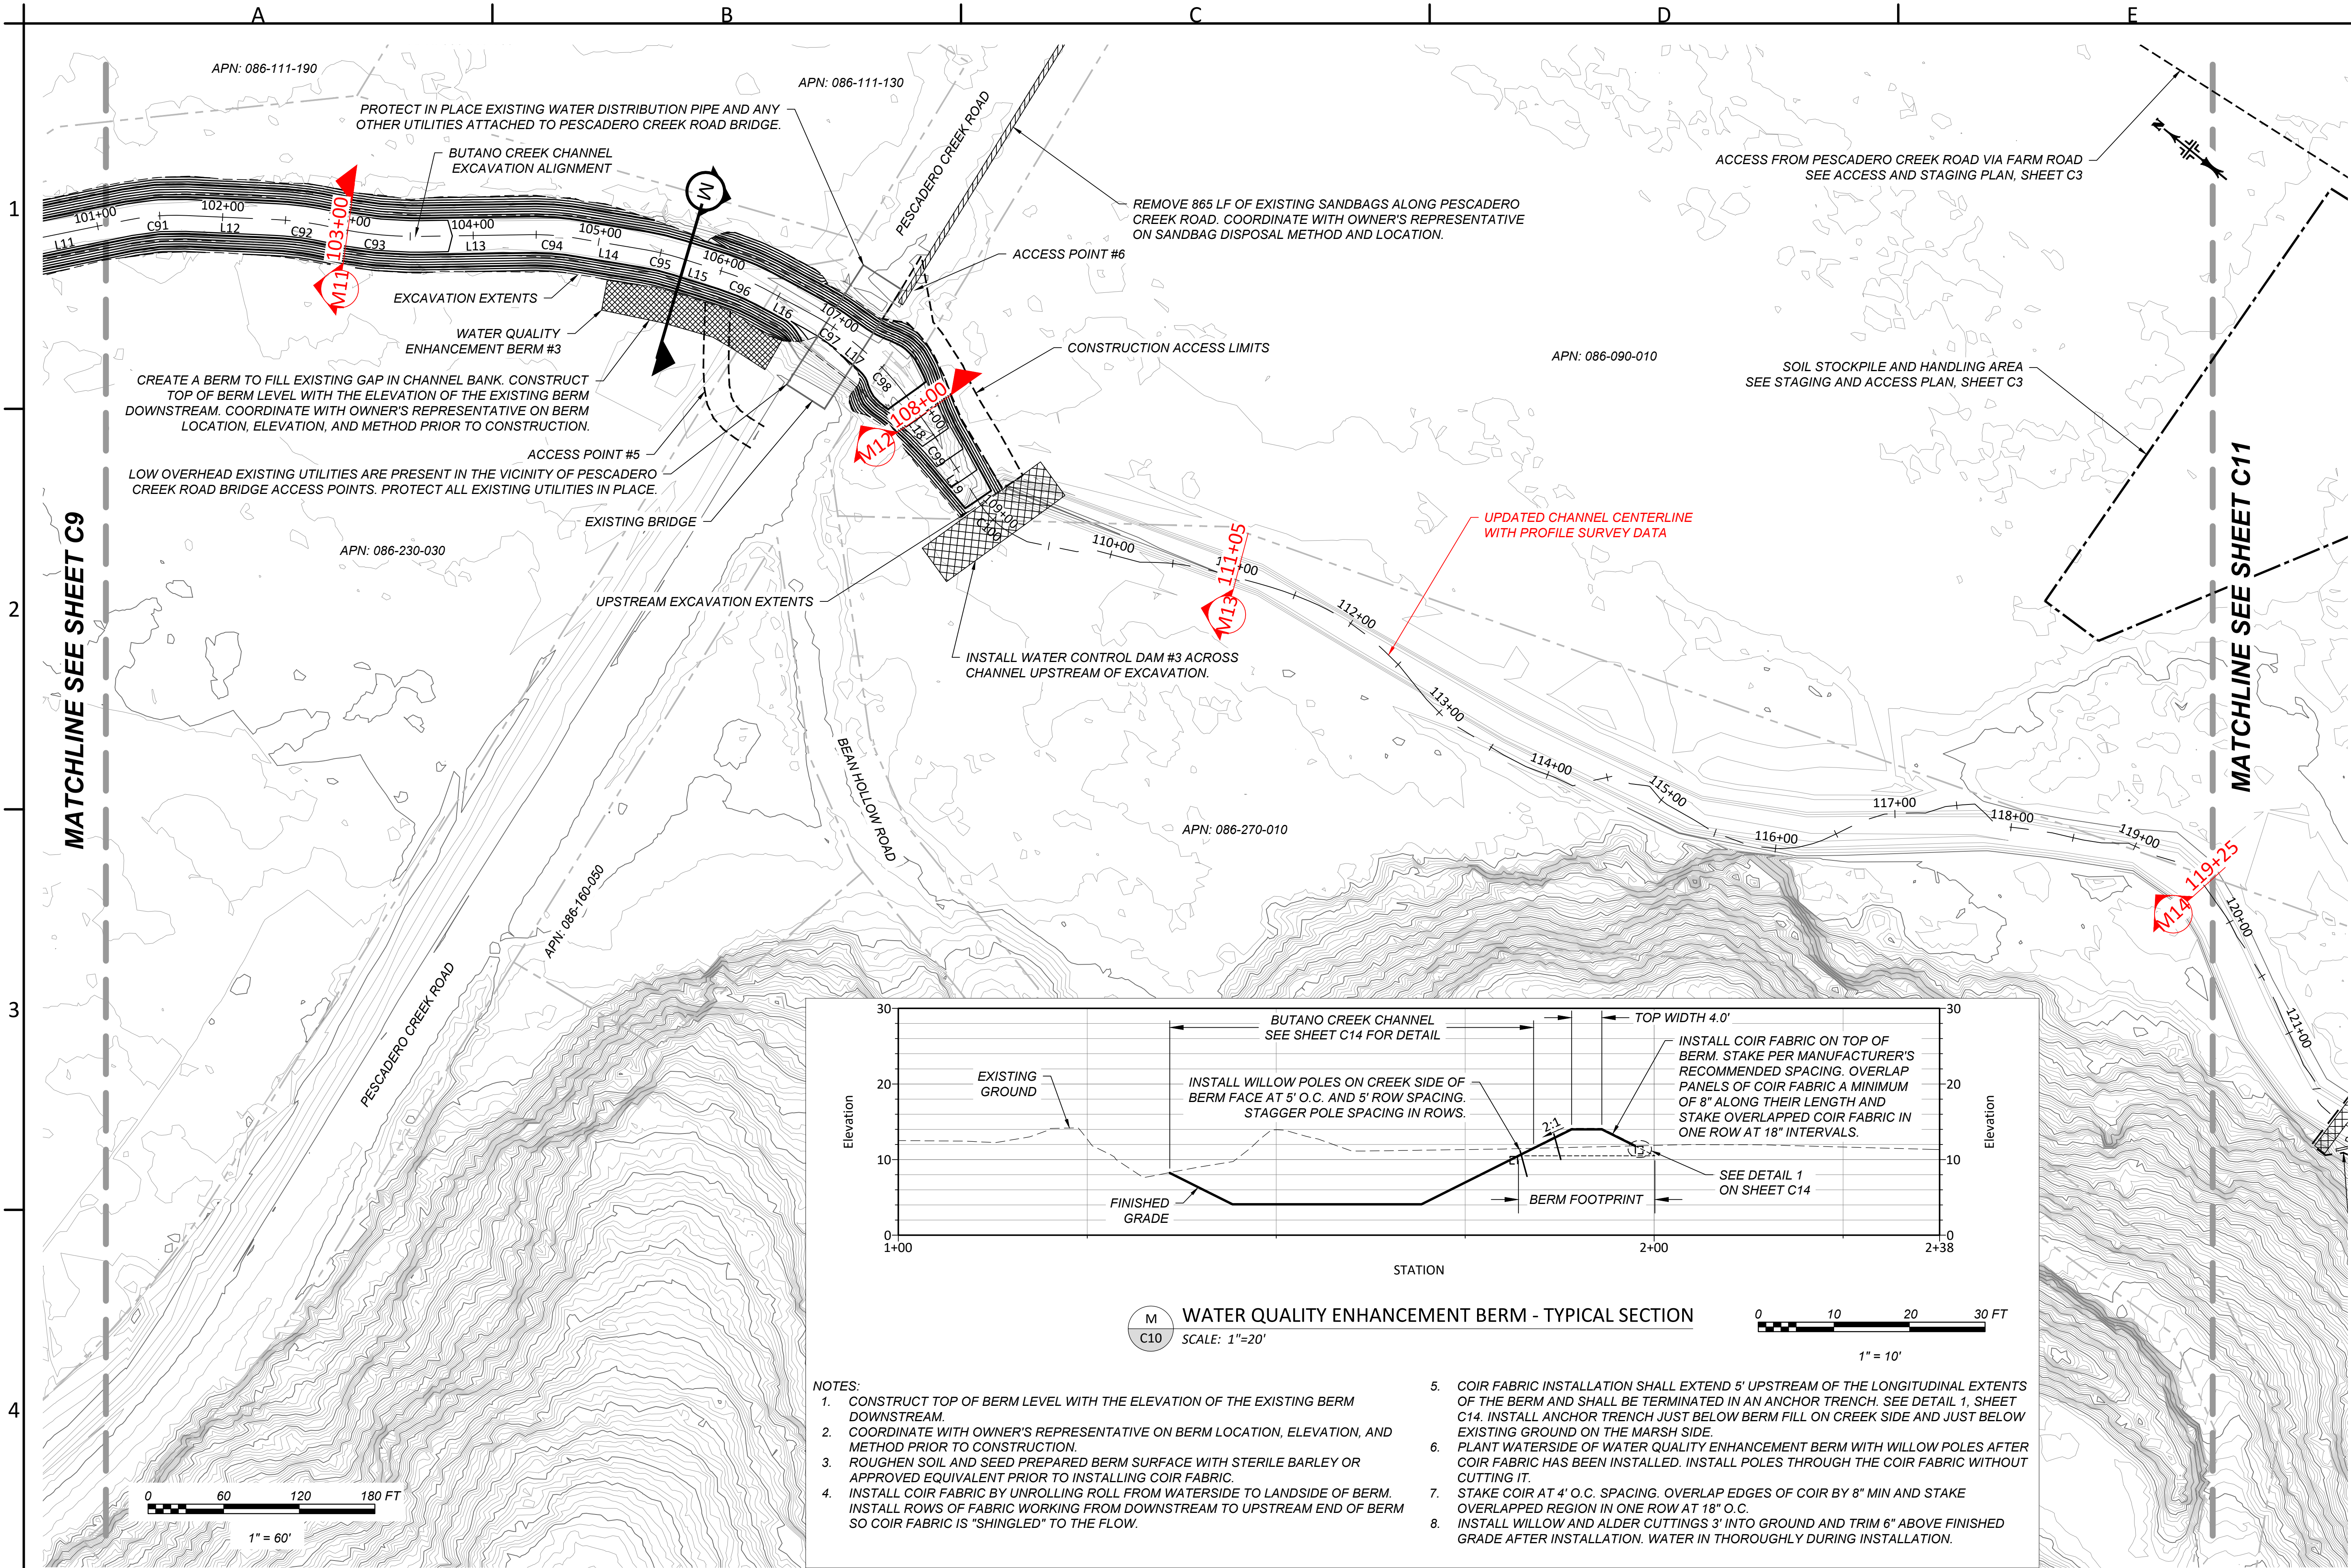

WATER QUALITY ENHANCEMENT BERM - TYPICAL SECTION
SCALE: 1"=20'

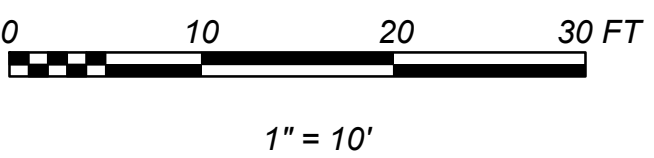


- NOTES:**
1. CONSTRUCT TOP OF BERM LEVEL WITH THE ELEVATION OF THE EXISTING BERM DOWNSTREAM.
 2. COORDINATE WITH OWNER'S REPRESENTATIVE ON BERM LOCATION, ELEVATION, AND METHOD PRIOR TO CONSTRUCTION.
 3. ROUGHEN SOIL AND SEED PREPARED BERM SURFACE WITH STERILE BARLEY OR APPROVED EQUIVALENT PRIOR TO INSTALLING COIR FABRIC.
 4. INSTALL COIR FABRIC BY UNROLLING ROLL FROM WATERSIDE TO LANDSIDE OF BERM. INSTALL ROWS OF FABRIC WORKING FROM DOWNSTREAM TO UPSTREAM END OF BERM SO COIR FABRIC IS "SHINGLED" TO THE FLOW.
 5. COIR FABRIC INSTALLATION SHALL EXTEND 5' UPSTREAM OF THE LONGITUDINAL EXTENTS OF THE BERM AND SHALL BE TERMINATED IN AN ANCHOR TRENCH. SEE DETAIL 1, SHEET C14. INSTALL ANCHOR TRENCH JUST BELOW BERM FILL ON CREEK SIDE AND JUST BELOW EXISTING GROUND ON THE MARSH SIDE.
 6. PLANT WATERSIDE OF WATER QUALITY ENHANCEMENT BERM WITH WILLOW POLES AFTER COIR FABRIC HAS BEEN INSTALLED. INSTALL POLES THROUGH THE COIR FABRIC WITHOUT CUTTING IT.
 7. STAKE COIR AT 4' O.C. SPACING. OVERLAP EDGES OF COIR BY 8" MIN AND STAKE OVERLAPPED REGION IN ONE ROW AT 18" O.C.
 8. INSTALL WILLOW AND ALDER CUTTINGS 3' INTO GROUND AND TRIM 6" ABOVE FINISHED GRADE AFTER INSTALLATION. WATER IN THOROUGHLY DURING INSTALLATION.

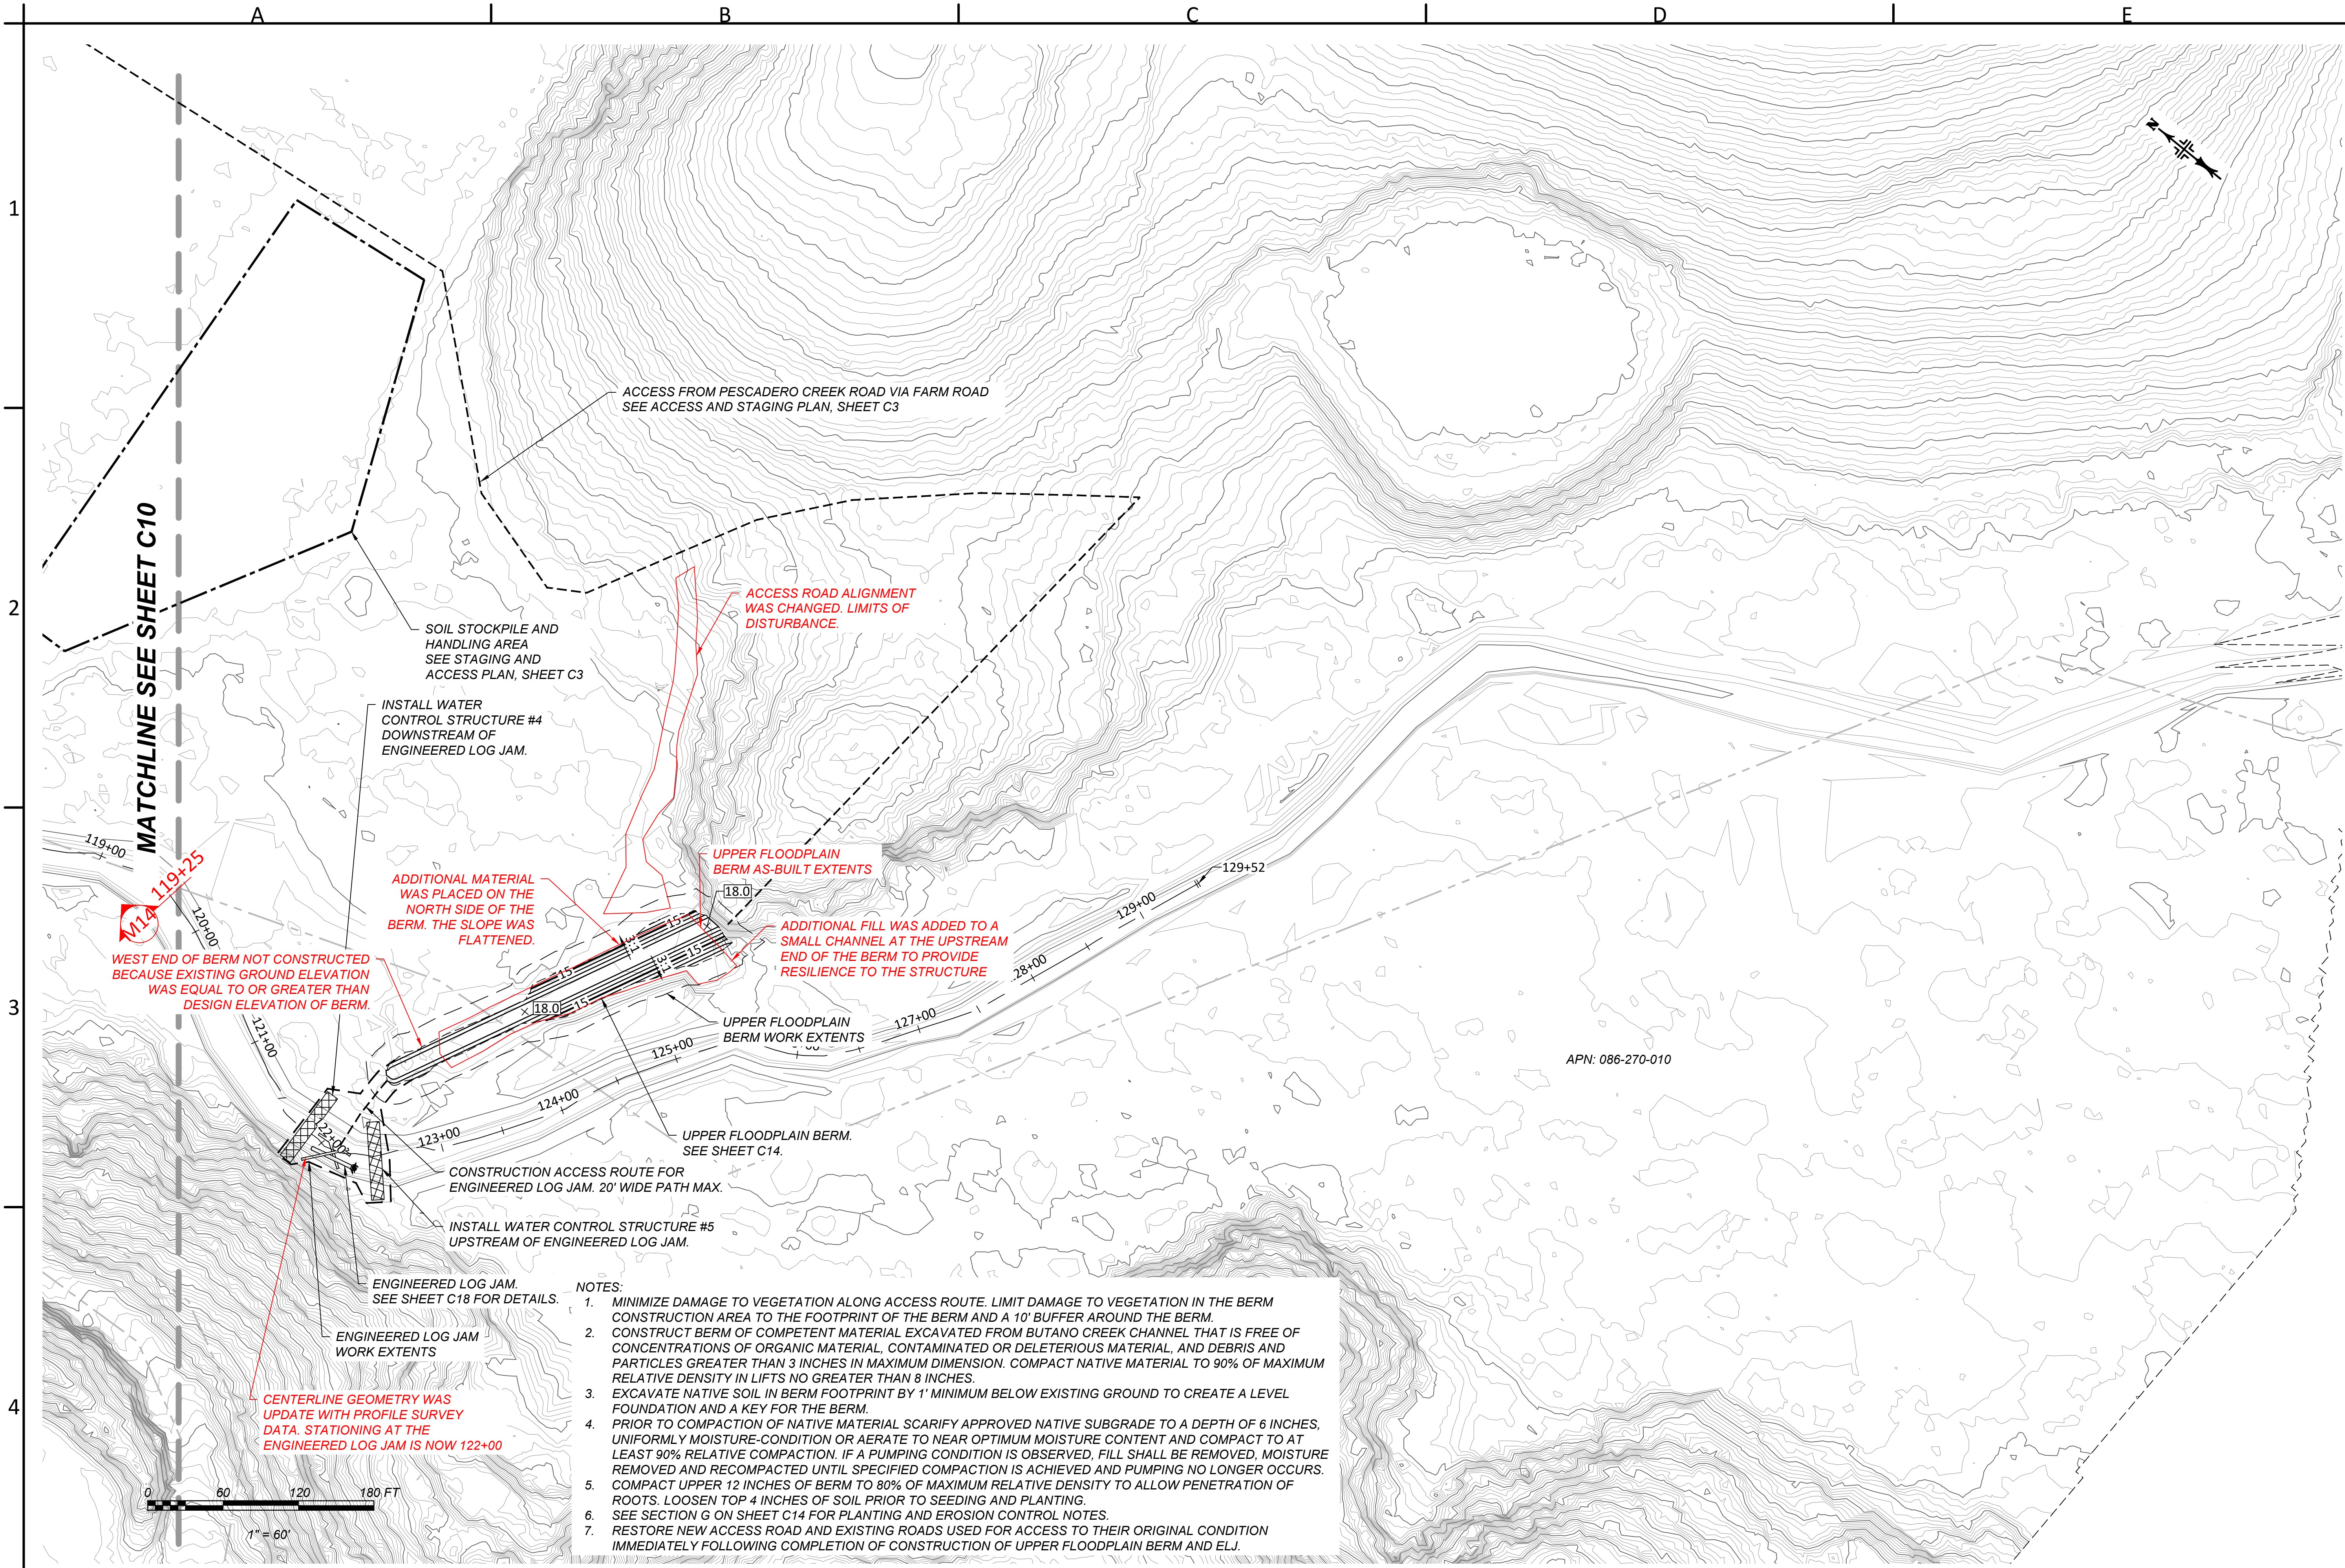


- NOTES:
1. MINIMIZE DAMAGE TO VEGETATION ALONG ACCESS ROUTE. LIMIT DAMAGE TO VEGETATION IN THE BERM CONSTRUCTION AREA TO THE FOOTPRINT OF THE BERM AND A 10' BUFFER AROUND THE BERM.
 2. CONSTRUCT BERM OF COMPETENT MATERIAL EXCAVATED FROM BUTANO CREEK CHANNEL THAT IS FREE OF CONCENTRATIONS OF ORGANIC MATERIAL, CONTAMINATED OR DELETERIOUS MATERIAL, AND DEBRIS AND PARTICLES GREATER THAN 3 INCHES IN MAXIMUM DIMENSION. COMPACT NATIVE MATERIAL TO 90% OF MAXIMUM RELATIVE DENSITY IN LIFTS NO GREATER THAN 8 INCHES.
 3. EXCAVATE NATIVE SOIL IN BERM FOOTPRINT BY 1' MINIMUM BELOW EXISTING GROUND TO CREATE A LEVEL FOUNDATION AND A KEY FOR THE BERM.
 4. PRIOR TO COMPACTION OF NATIVE MATERIAL SCARIFY APPROVED NATIVE SUBGRADE TO A DEPTH OF 6 INCHES, UNIFORMLY MOISTURE-CONDITION OR AERATE TO NEAR OPTIMUM MOISTURE CONTENT AND COMPACT TO AT LEAST 90% RELATIVE COMPACTION. IF A PUMPING CONDITION IS OBSERVED, FILL SHALL BE REMOVED, MOISTURE REMOVED AND RECOMPACTED UNTIL SPECIFIED COMPACTION IS ACHIEVED AND PUMPING NO LONGER OCCURS.
 5. COMPACT UPPER 12 INCHES OF BERM TO 80% OF MAXIMUM RELATIVE DENSITY TO ALLOW PENETRATION OF ROOTS. LOOSEN TOP 4 INCHES OF SOIL PRIOR TO SEEDING AND PLANTING.
 6. SEE SECTION G ON SHEET C14 FOR PLANTING AND EROSION CONTROL NOTES.
 7. RESTORE NEW ACCESS ROAD AND EXISTING ROADS USED FOR ACCESS TO THEIR ORIGINAL CONDITION IMMEDIATELY FOLLOWING COMPLETION OF CONSTRUCTION OF UPPER FLOODPLAIN BERM AND ELJ.

USE OF DOCUMENTS THIS DOCUMENT, INCLUDING THE INCORPORATED DESIGN, SHALL NOT BE USED FOR ANY OTHER PROJECT AND SHALL NOT BE REPRODUCED OR TRANSMITTED IN ANY FORM OR BY ANY MEANS, ELECTRONIC OR MECHANICAL, INCLUDING PHOTOCOPYING, RECORDING, OR BY ANY INFORMATION SYSTEM, WITHOUT THE WRITTEN AUTHORIZATION OF cbec, inc.	DOCUMENT RELEASE	DESIGNED	CH/JS/SD
		DRAWN	JP/JM
		REVIEWED	SD
		APPROVED	CH
PREPARED BY:		AS-BUILT	
		REVISION NOTES	
CLIENT:		SAN MATEO	
		RESOURCE CONSERVATION DISTRICT	
PESCADERO	CALIFORNIA	80 STONE PINE ROAD #100	
		HALF MOON BAY, CA 94019	
BUTANO CREEK CHANNEL RECONNECTION AND RESILIENCE PROJECT		(650) 712-7765	
JOB NUMBER		16-1027-4	
DATE		FEB 2020	
SHEET		C11	
		11 OF 19	


1

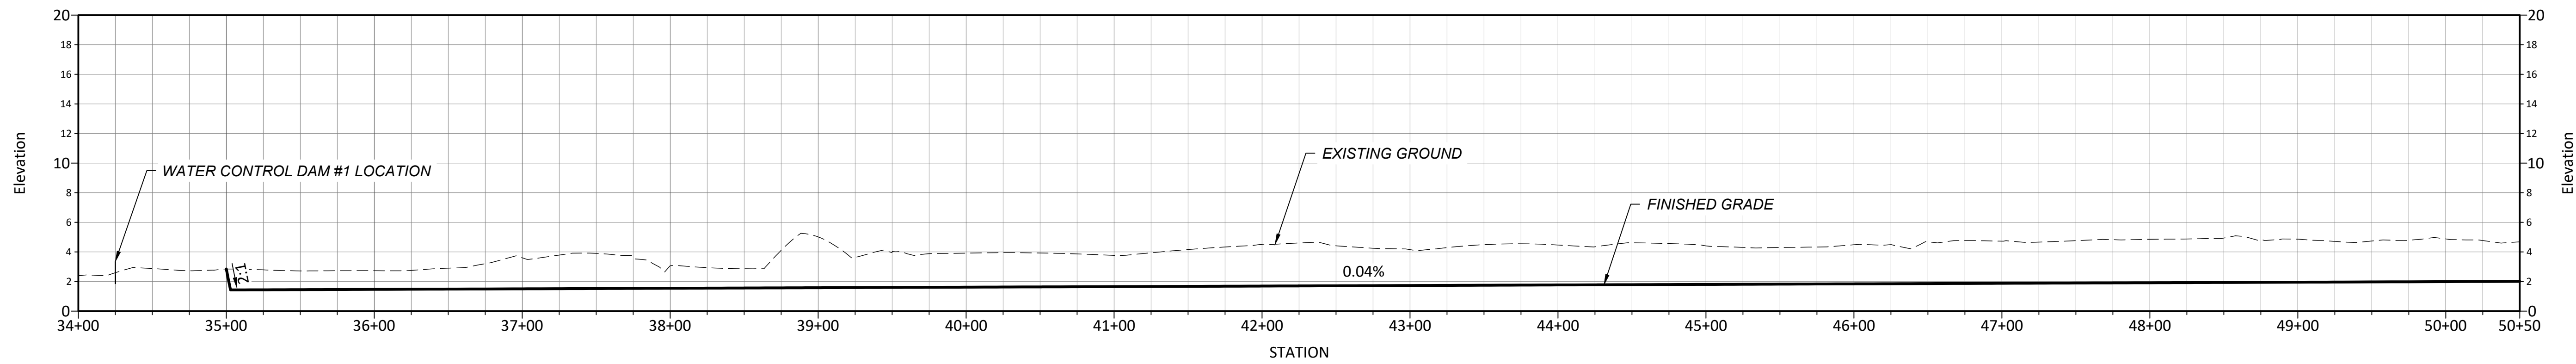


2

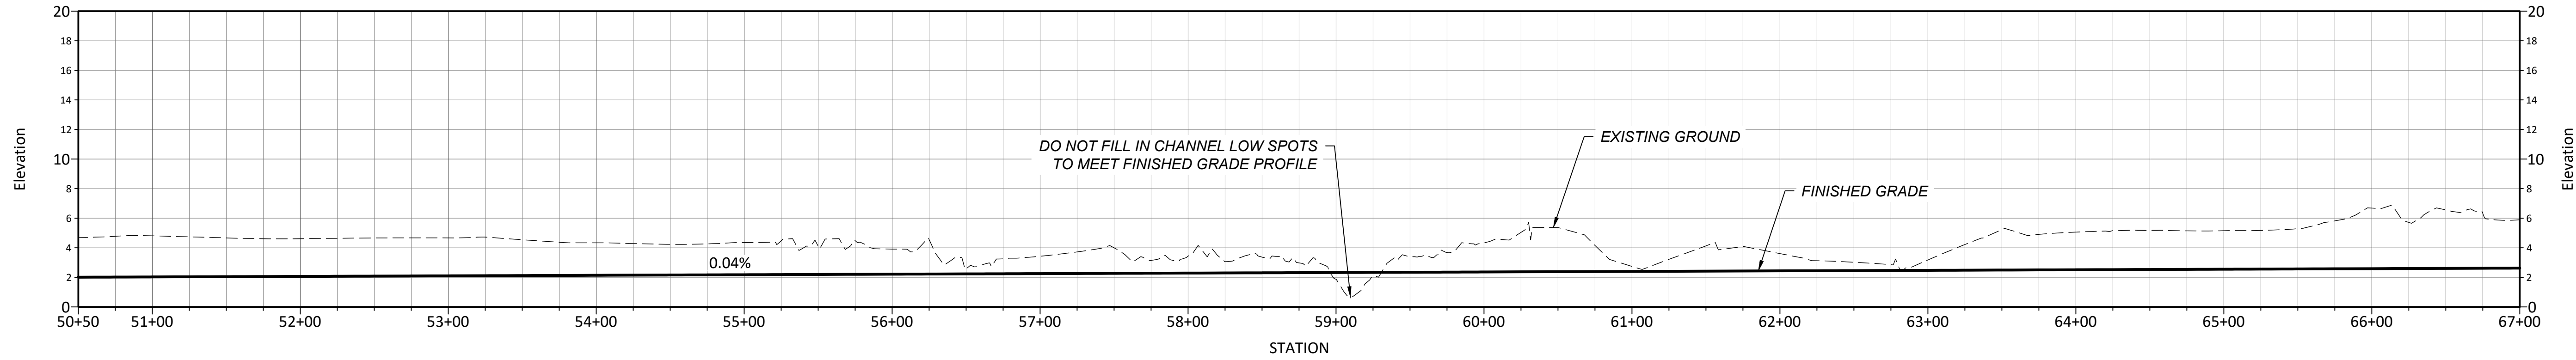


3

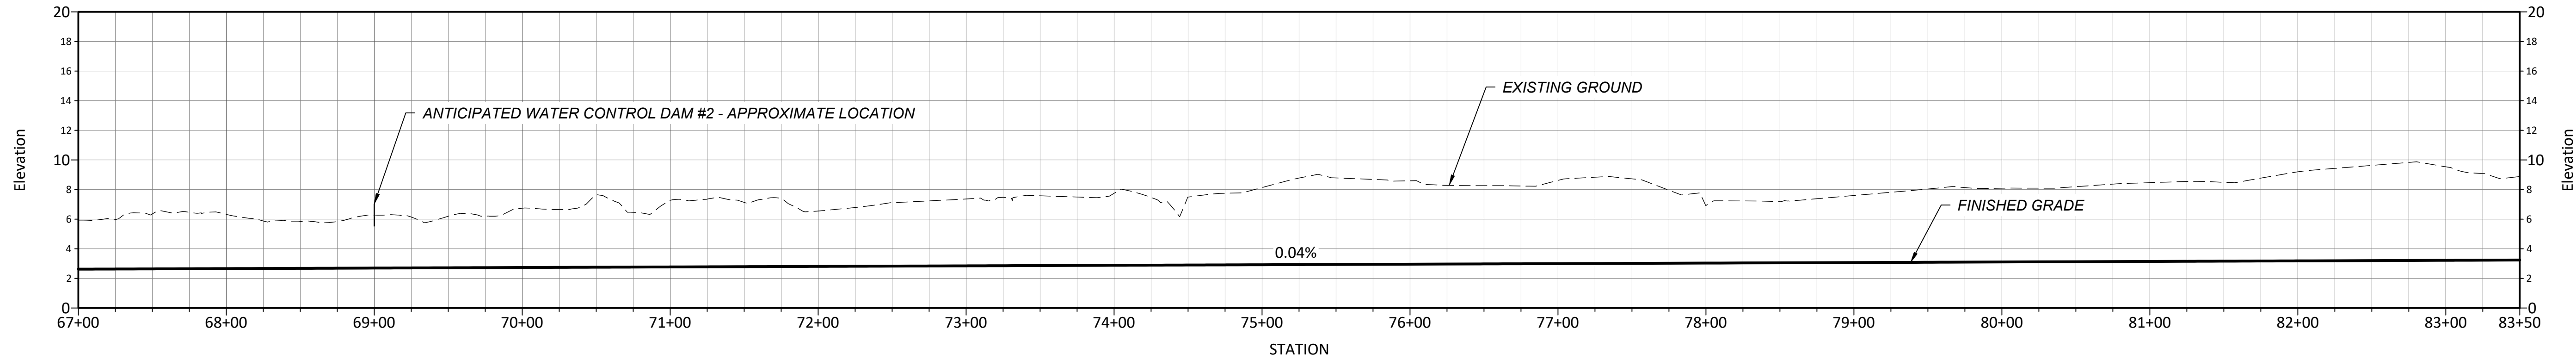

4

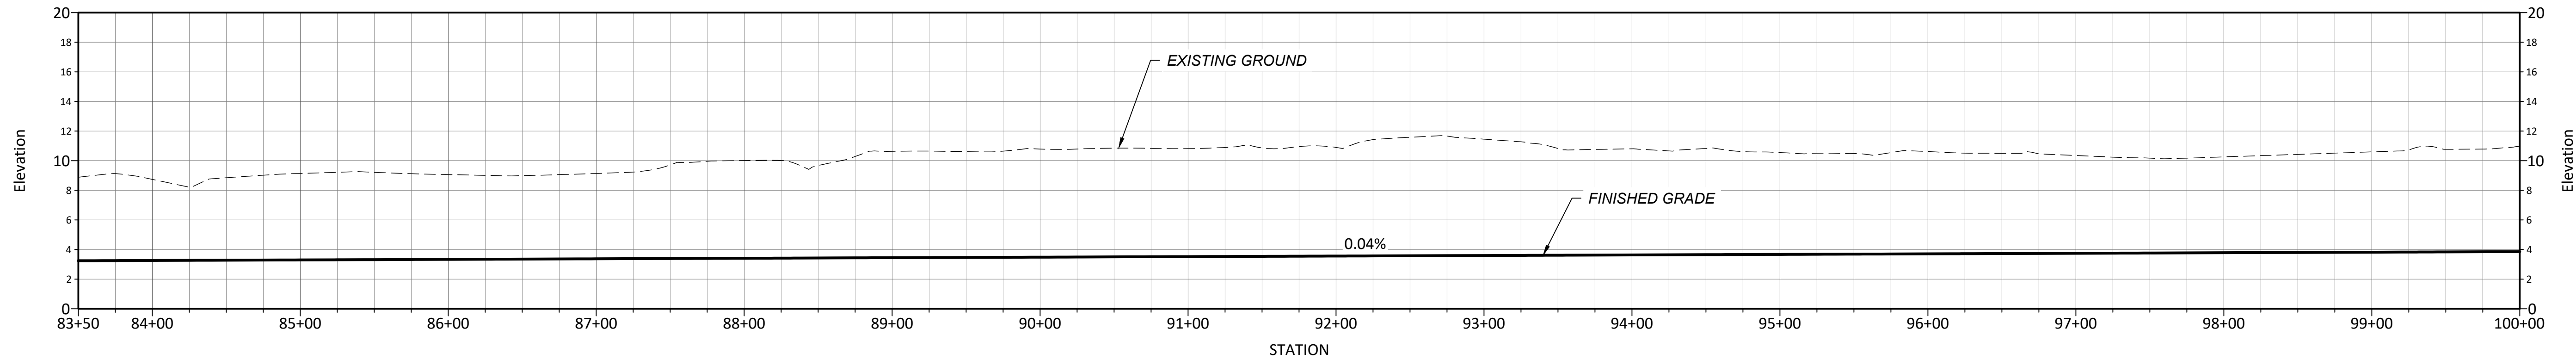

DESIGNED CH/JS/SD DRAWN JP/JM REVIEWED SD APPROVED CH	DOCUMENT RELEASE DRAFT 100%	USE OF DOCUMENTS THIS DOCUMENT, INCLUDING THE INCORPORATED SHEETS, IS THE PROPERTY OF cbec, inc. IT IS NOT TO BE REPRODUCED OR TRANSMITTED IN ANY FORM OR BY ANY MEANS, ELECTRONIC OR MECHANICAL, INCLUDING PHOTOCOPYING, RECORDING, OR BY ANY INFORMATION SYSTEM, WITHOUT THE WRITTEN AUTHORIZATION OF cbec, inc.				
		REVISION NOTES				
PREPARED BY: 						
CLIENT: SAN MATEO RESOURCE CONSERVATION DISTRICT 80 STONE PINE ROAD #100 HALF MOON BAY, CA 94019 (650) 712-7765						
PESCADERO CALIFORNIA BUTANO CREEK CHANNEL RECONNECTION AND RESILIENCE PROJECT CHANNEL PROFILE (1 OF 2)						
JOB NUMBER 16-1027-3						
DATE OCT 2018						
SHEET C12 12 OF 19						

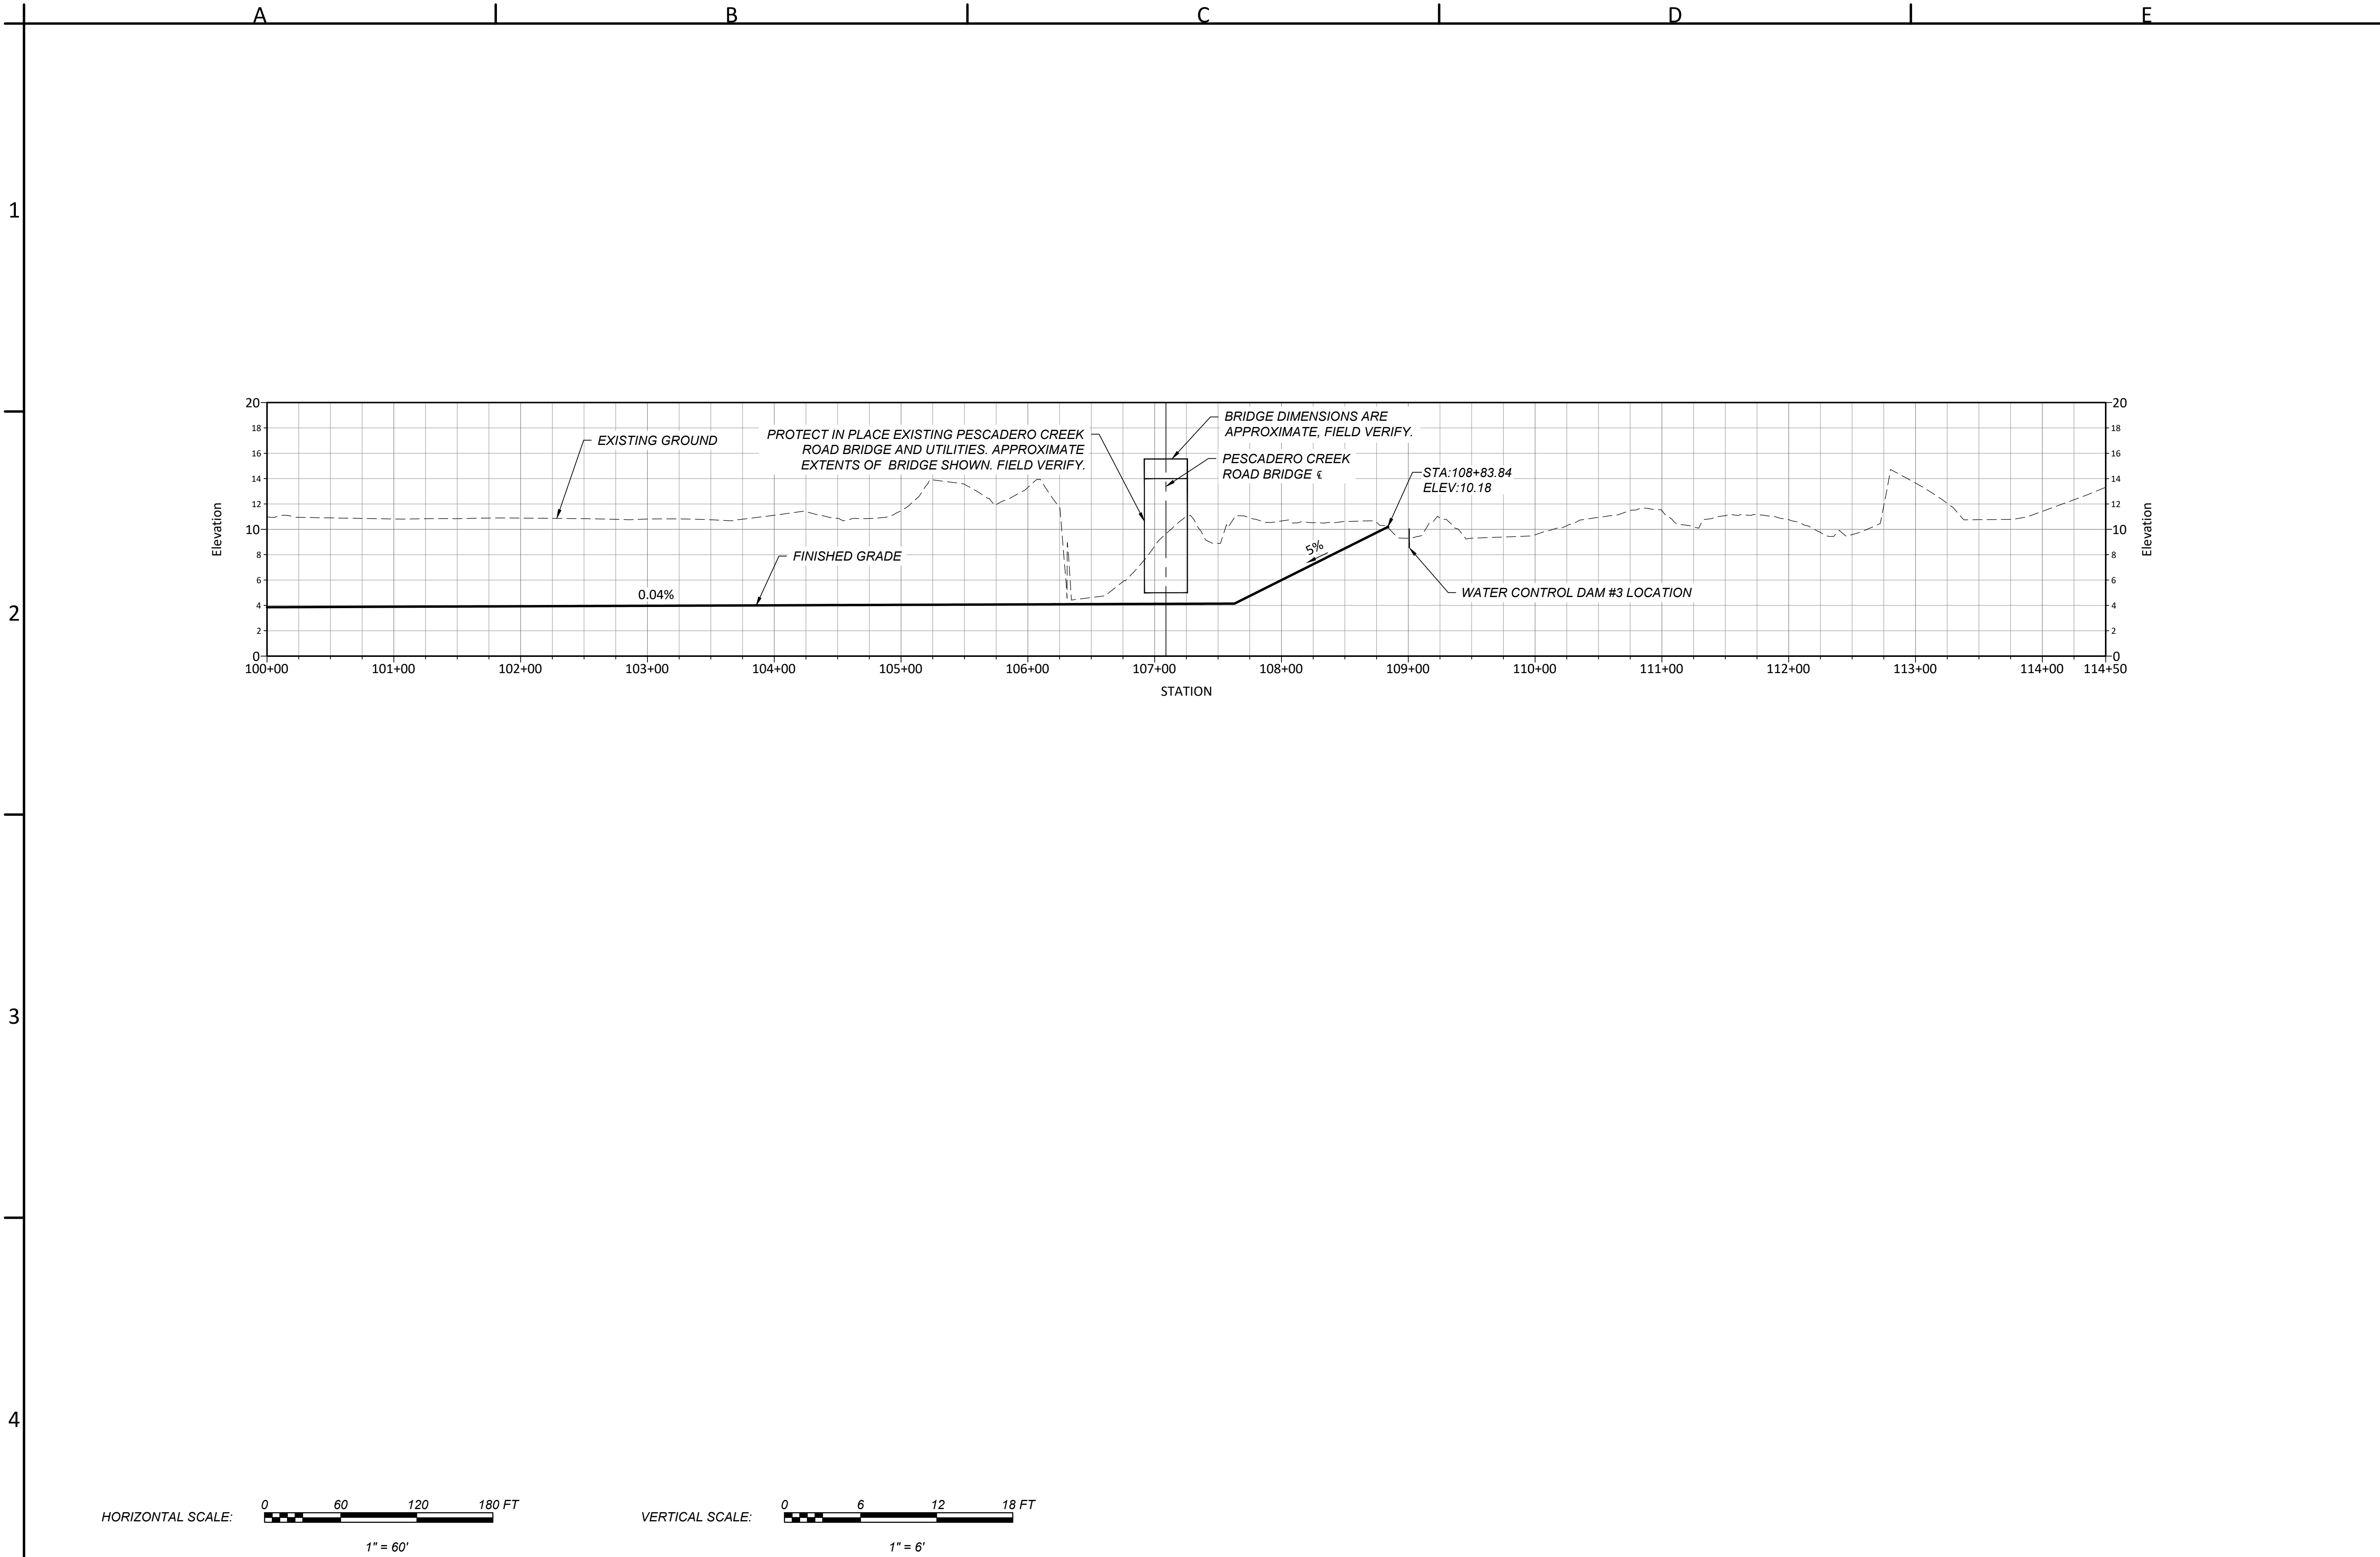

USE OF DOCUMENTS
THIS DOCUMENT, INCLUDING
THE INCORPORATED
SHEETS, IS TO BE USED
FOR THE PROJECT ONLY.
IT IS NOT TO BE
REPRODUCED OR
TRANSMITTED IN ANY
FORM OR BY ANY
MEANS, ELECTRONIC
OR MECHANICAL,
INCLUDING PHOTOCOPYING,
RECORDING, OR BY
ANY INFORMATION
SYSTEM, WITHOUT
WRITTEN AUTHORIZATION
OF cbec, inc.

DOCUMENT RELEASE
DRAFT 100%
REVISION NOTES

DESIGNED
CH/JS/SD
DRAWN
JP/JM
REVIEWED
SD
APPROVED
CH

PREPARED BY:

c b e c
eco engineering


CLIENT:
SAN MATEO
RESOURCE CONSERVATION DISTRICT
80 STONE PINE ROAD #100
HALF MOON BAY, CA 94019
(650) 712-7765

PESCADERO
BUTANO CREEK CHANNEL RECONNECTION
AND RESILIENCE PROJECT
CHANNEL PROFILE (2 OF 2)

JOB NUMBER
16-1027-3

DATE
OCT 2018


SHEET
C13
13 OF 19

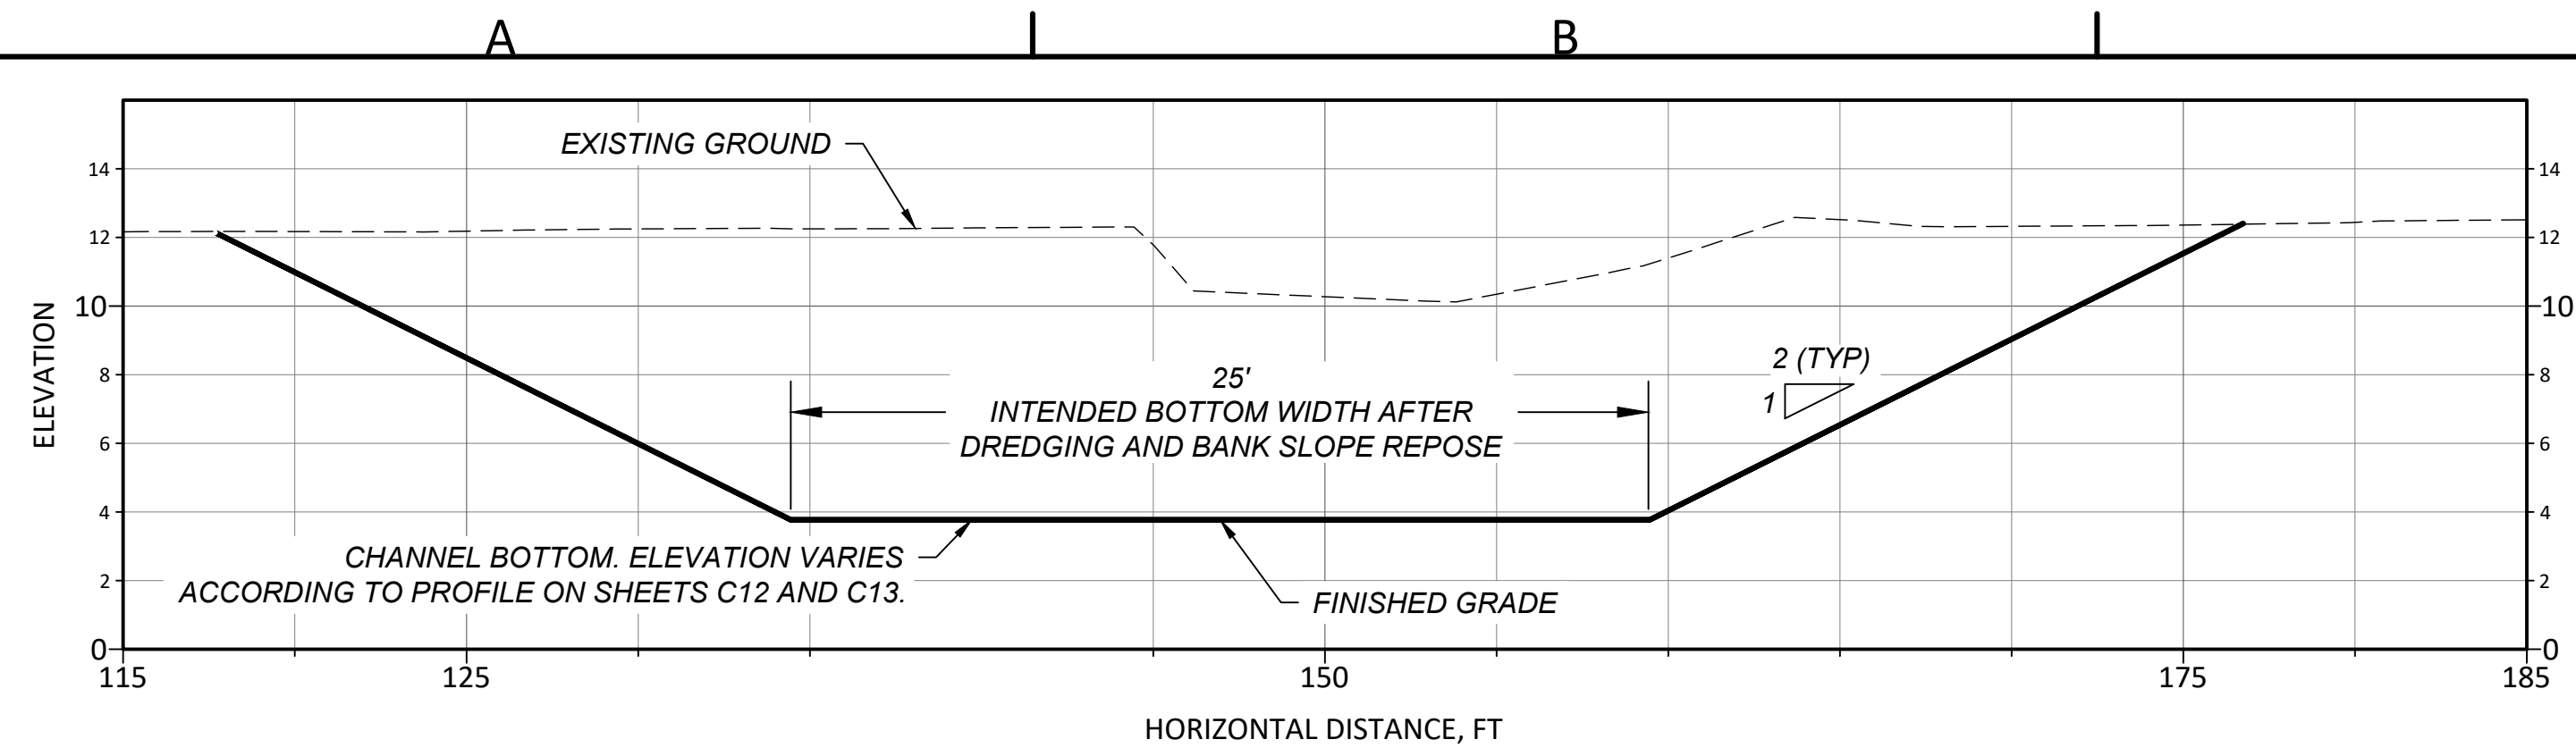


TYPICAL BUTANO CREEK CHANNEL DREDGE SECTION
SCALE: 1"=5'

NOTES:

1. DREDGING SHALL MAINTAIN THE DESIGN CROSS-SECTIONAL AREA OF THE CHANNEL AS REPRESENTED BY FINISHED GRADE LINES AND CONTOURS.
2. DREDGE CHANNEL IN STEPS TO APPROXIMATE DESIGN SLOPES WHERE DEPTH OF DREDGING IS GREATER THAN 3'.
3. PREPARE AND SUBMIT A PRELIMINARY DREDGING PLAN OF OPERATION TO THE OWNER'S REPRESENTATIVE FOR APPROVAL PRIOR TO DREDGING.

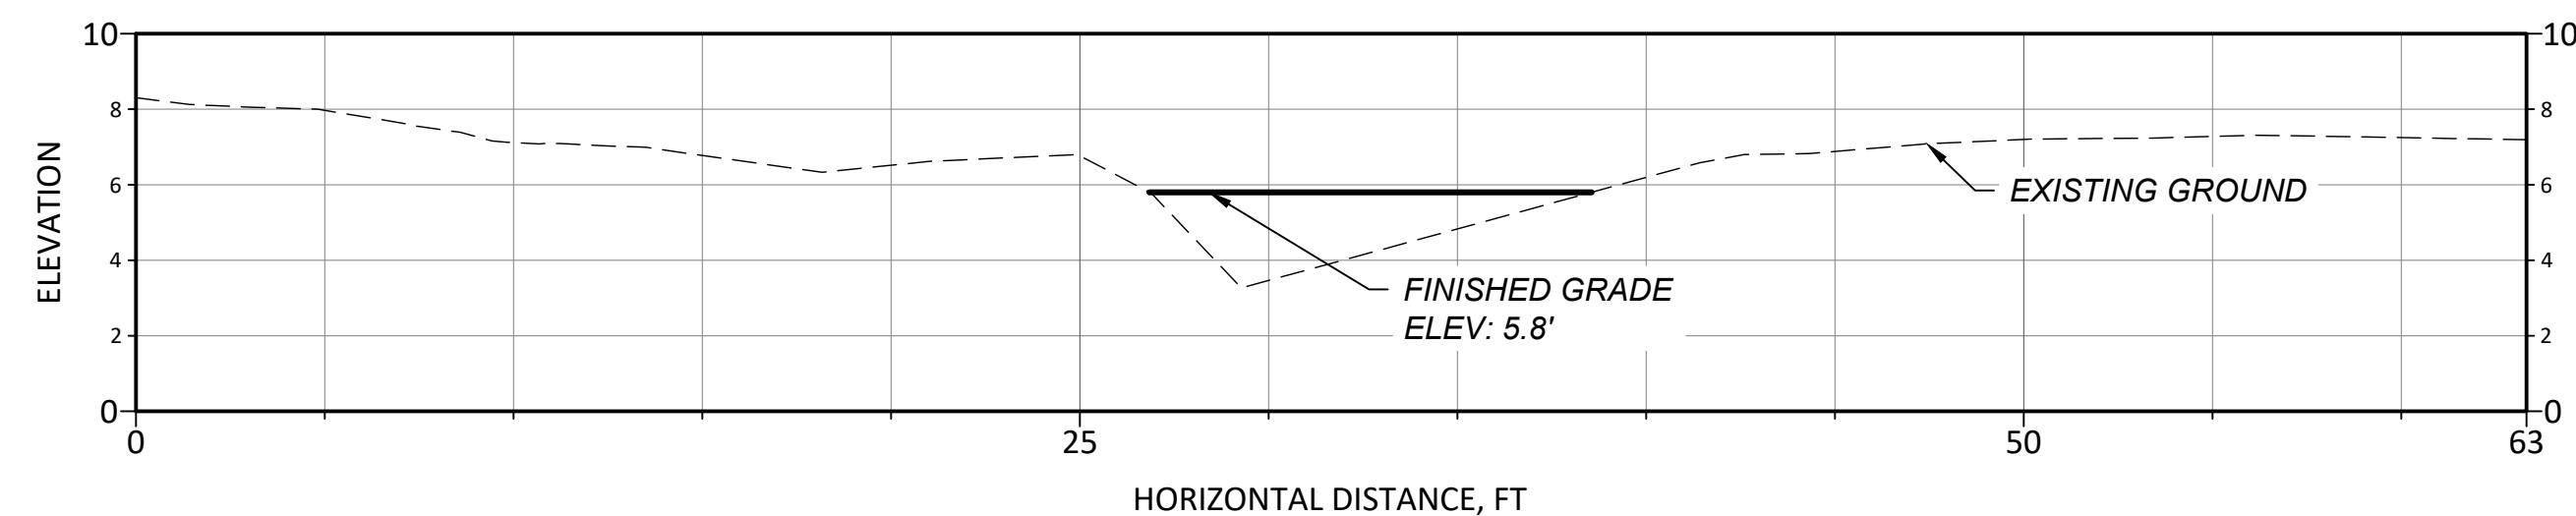


SEDIMENT REUSE SECTION - TYPE 3 FILL
SCALE: 1"=5'

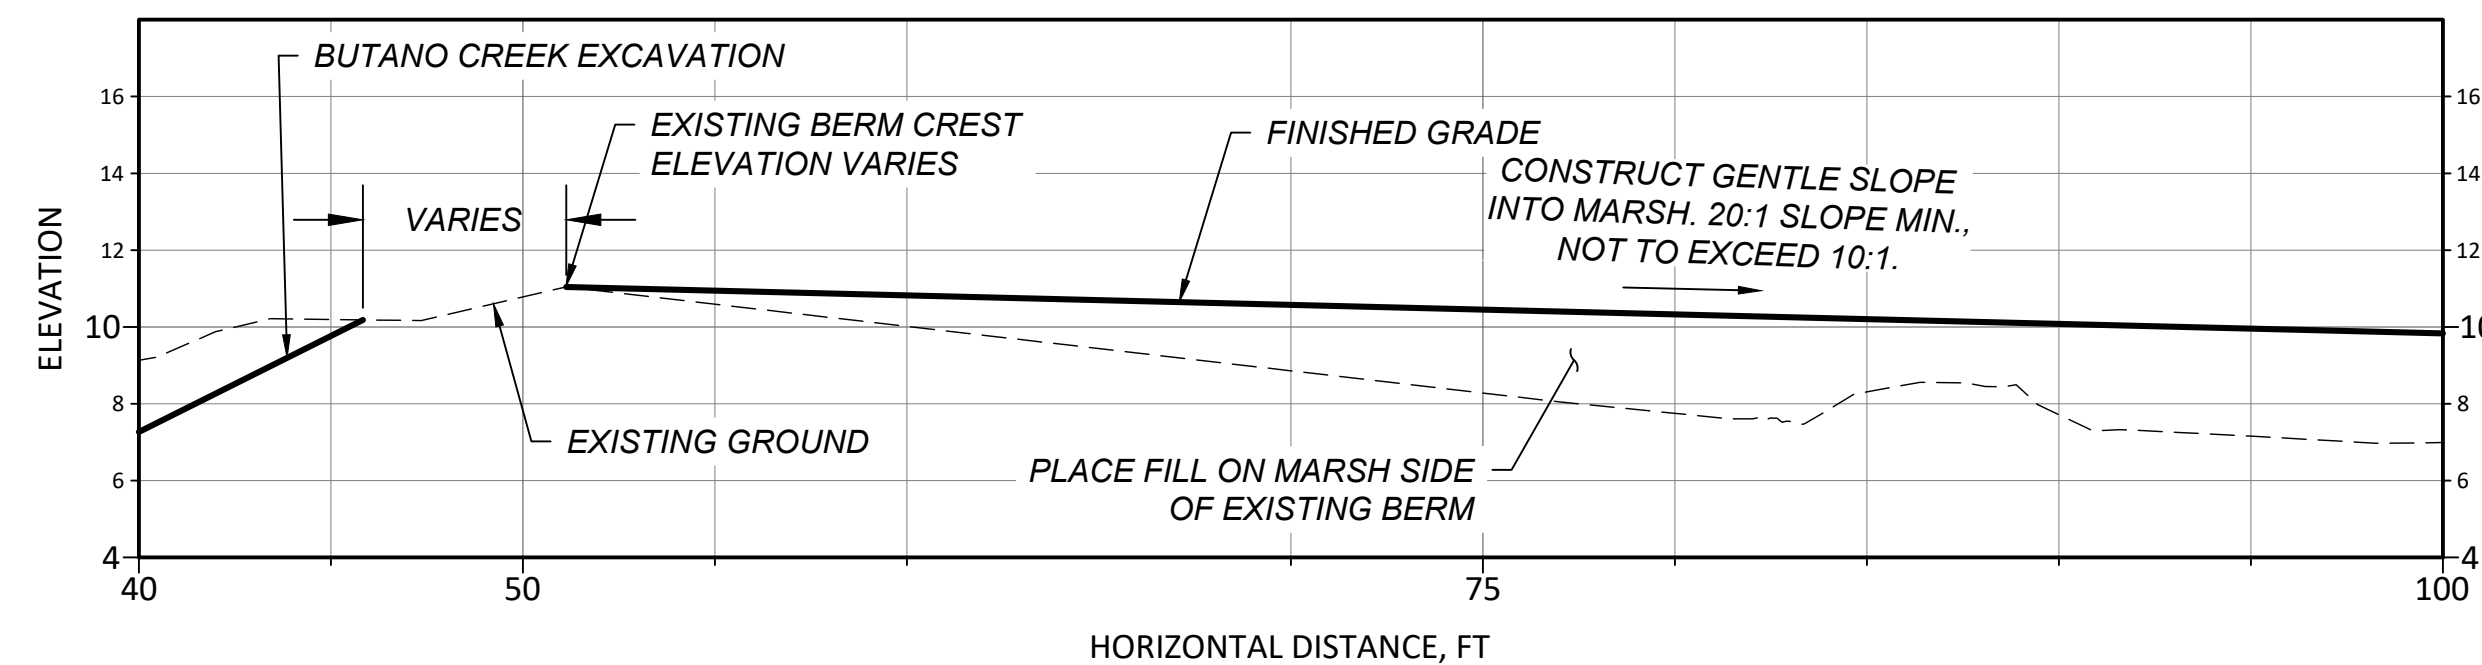

E SEDIMENT REUSE SECTION - TYPE 5 FILL - NATURAL LEVEE ANALOG
C8 SCALE: 1"=5'

NOTES:

1. VEGETATION CLEARING AND STRIPPING FOR HAUL ROUTE SHALL BE DONE IN THE PRESENCE OF A BIOLOGICAL MONITOR.
2. VEGETATION SHALL BE CLEARED IN TWO PASSES. THE FIRST PASS SHALL REDUCE VEGETATION TO 1' ABOVE GROUND. THE SECOND PASS SHALL REDUCE VEGETATION TO 3" ABOVE GROUND.
3. SUBMIT A MOWING AND STRIPPING PLAN TO OWNER'S REPRESENTATIVE FOR APPROVAL.

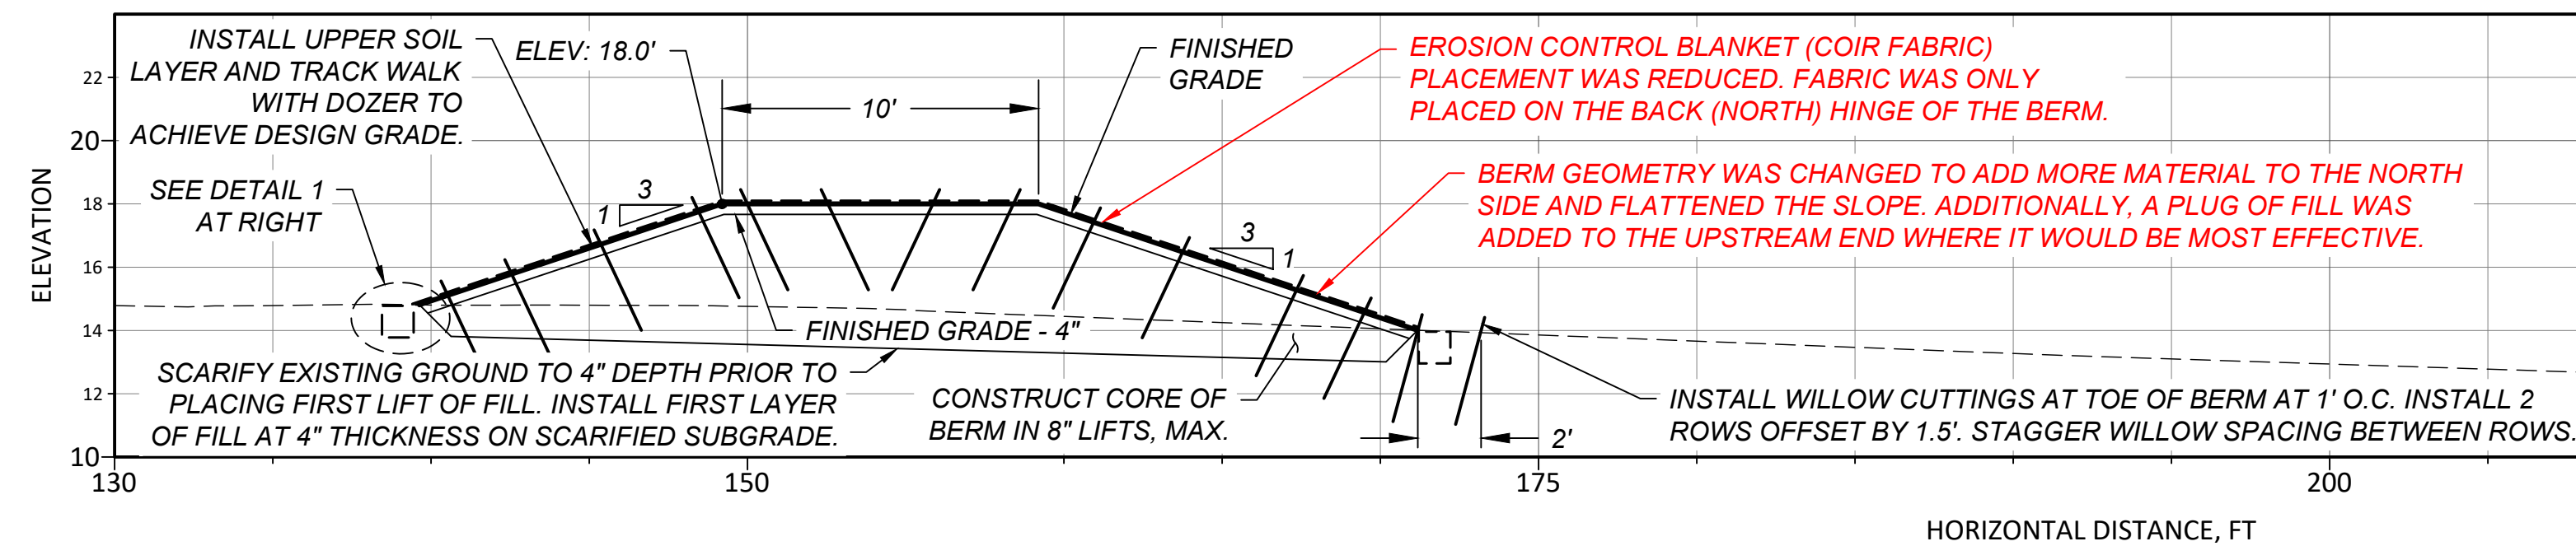


G C11 UPPER FLOODPLAIN BERM SECTION
SCALE: 1"=5'

NOTES:


1. TOP ELEVATION OF UPPER FLOODPLAIN BERM IS CONSTANT. HEIGHT OF BERM VARIES ACCORDING TO CHANGES IN EXISTING GROUND TOPOGRAPHY.
2. ROUGHEN SOIL AND SEED PREPARED BERM SURFACE WITH STERILE BARLEY OR APPROVED EQUIVALENT PRIOR TO INSTALLING COIR FABRIC.

3. INSTALL COIR FABRIC BY UNROLLING ROLL FROM WATERSIDE TO LANDSIDE OF BERM. INSTALL ROWS OF FABRIC WORKING FROM DOWNSTREAM TO UPSTREAM END OF BERM SO COIR FABRIC IS "SHINGLED" TO THE FLOW.
4. COIR FABRIC INSTALLATION SHALL EXTEND 5' UPSTREAM OF THE LONGITUDINAL EXTENTS OF THE BERM AND SHALL BE TERMINATED IN AN ANCHOR TRENCH. SEE DETAIL 1, THIS SHEET.


5. PLANT UPPER FLOODPLAIN BERM WITH WILLOW AND ALDER CUTTINGS AFTER COIR FABRIC HAS BEEN INSTALLED. INSTALL POLES THROUGH THE COIR FABRIC WITHOUT CUTTING IT.
6. STAKE COIR AT 4' O.C. SPACING. OVERLAP EDGES OF COIR BY 8" MIN AND STAKE OVERLAPPED REGION IN ONE ROW AT 18" O.C.
7. INSTALL WILLOW AND ALDER CUTTINGS 3' INTO GROUND AND TRIM 6" ABOVE FINISHED GRADE AFTER INSTALLATION. WATER IN THOROUGHLY DURING INSTALLATION.

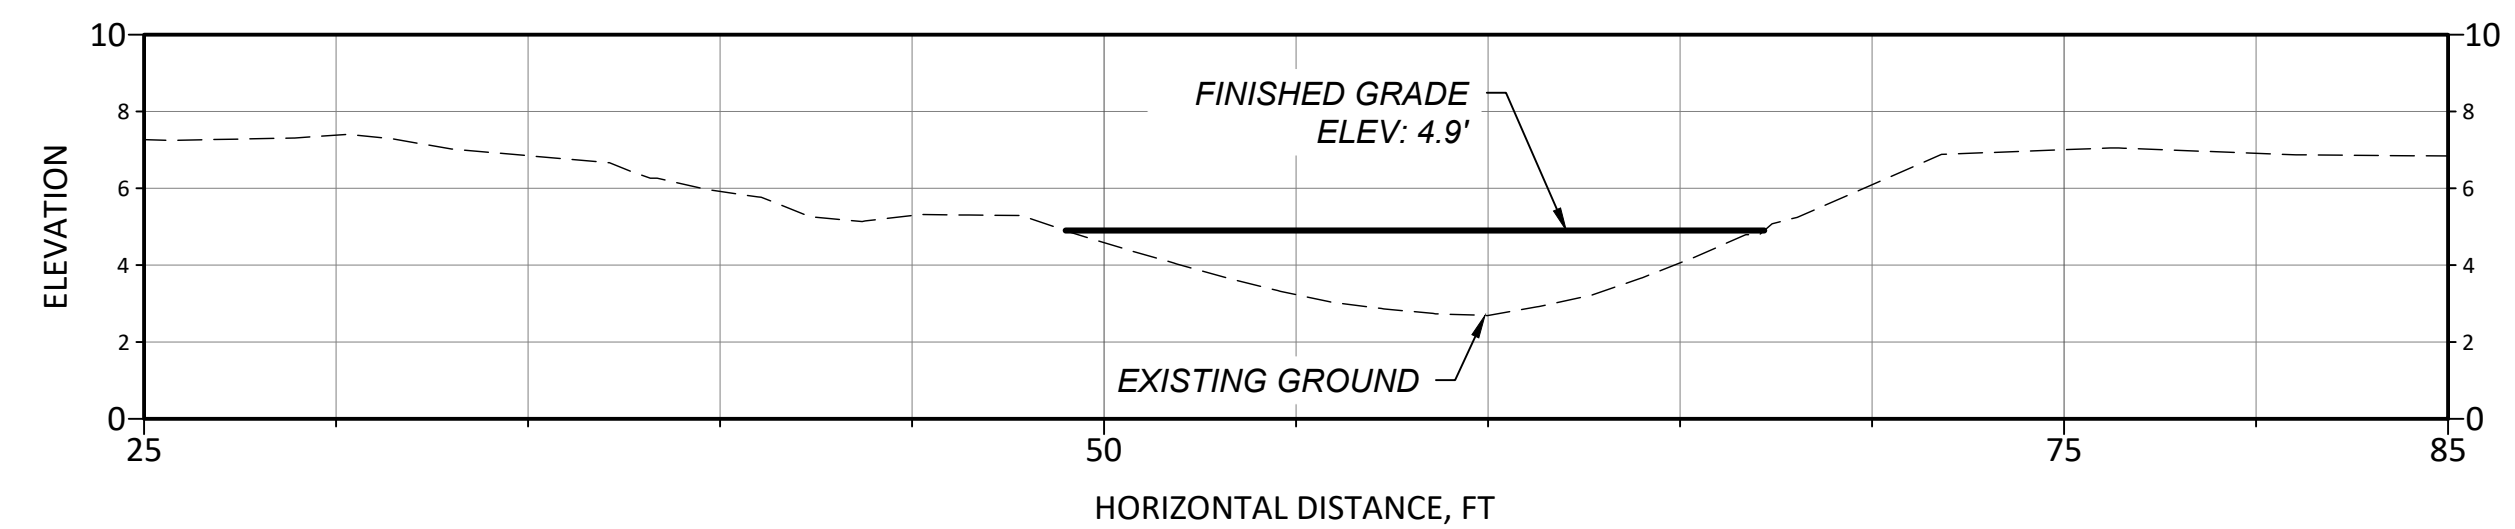

B SEDIMENT REUSE SECTION - TYPE 1 FILL
C6 SCALE: 1"=5'

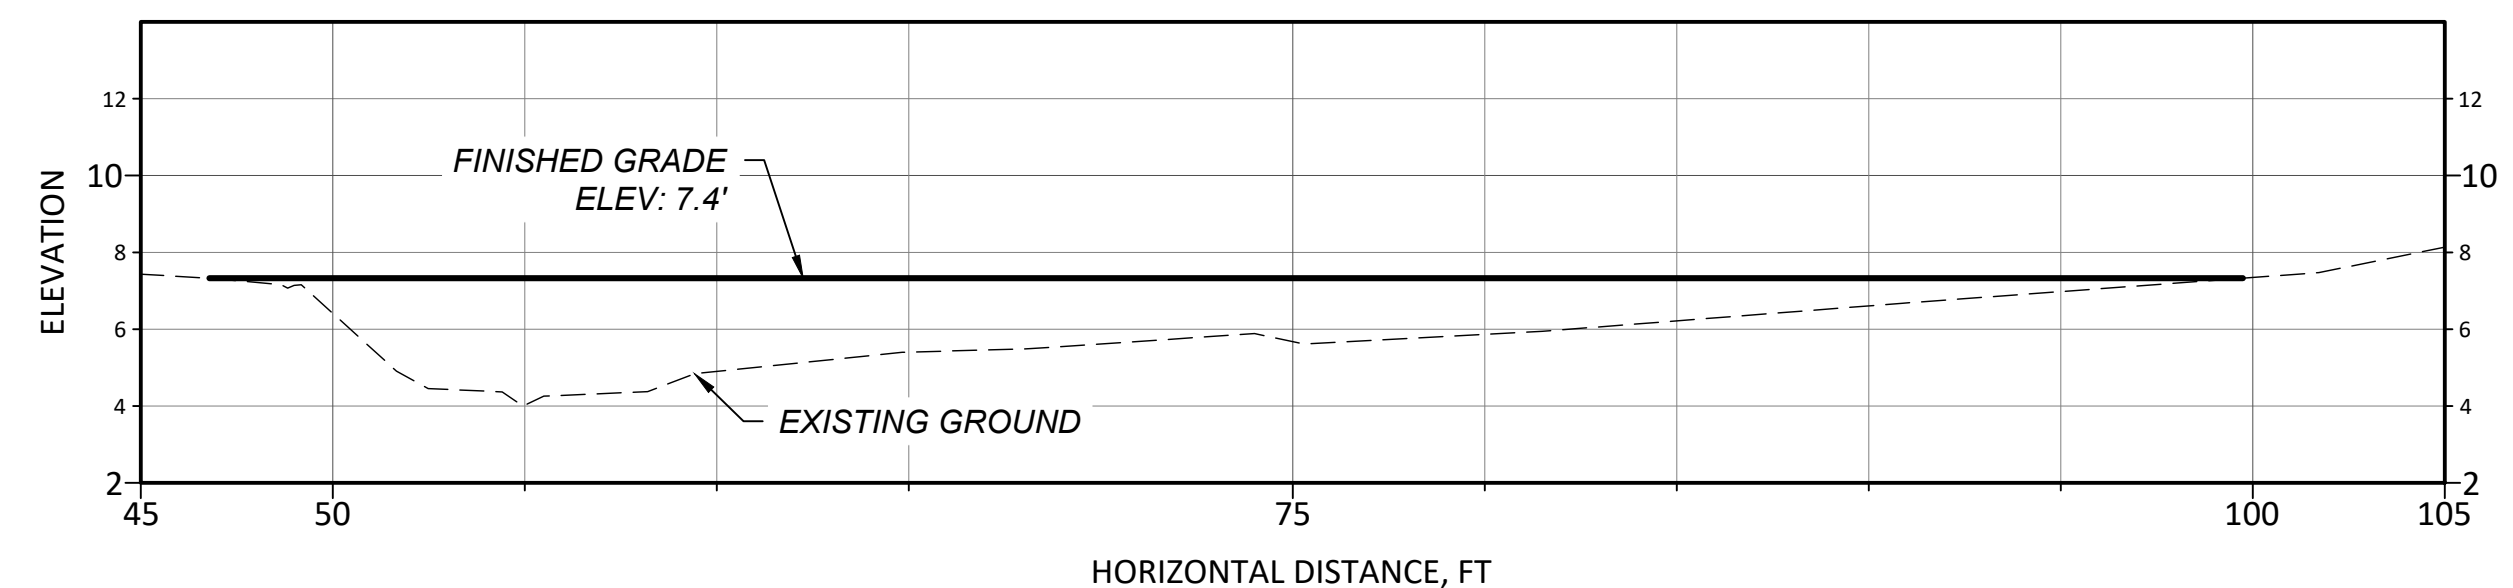


D SEDIMENT REUSE SECTION - TYPE 4 FILL
C7 SCALE: 1"=5'

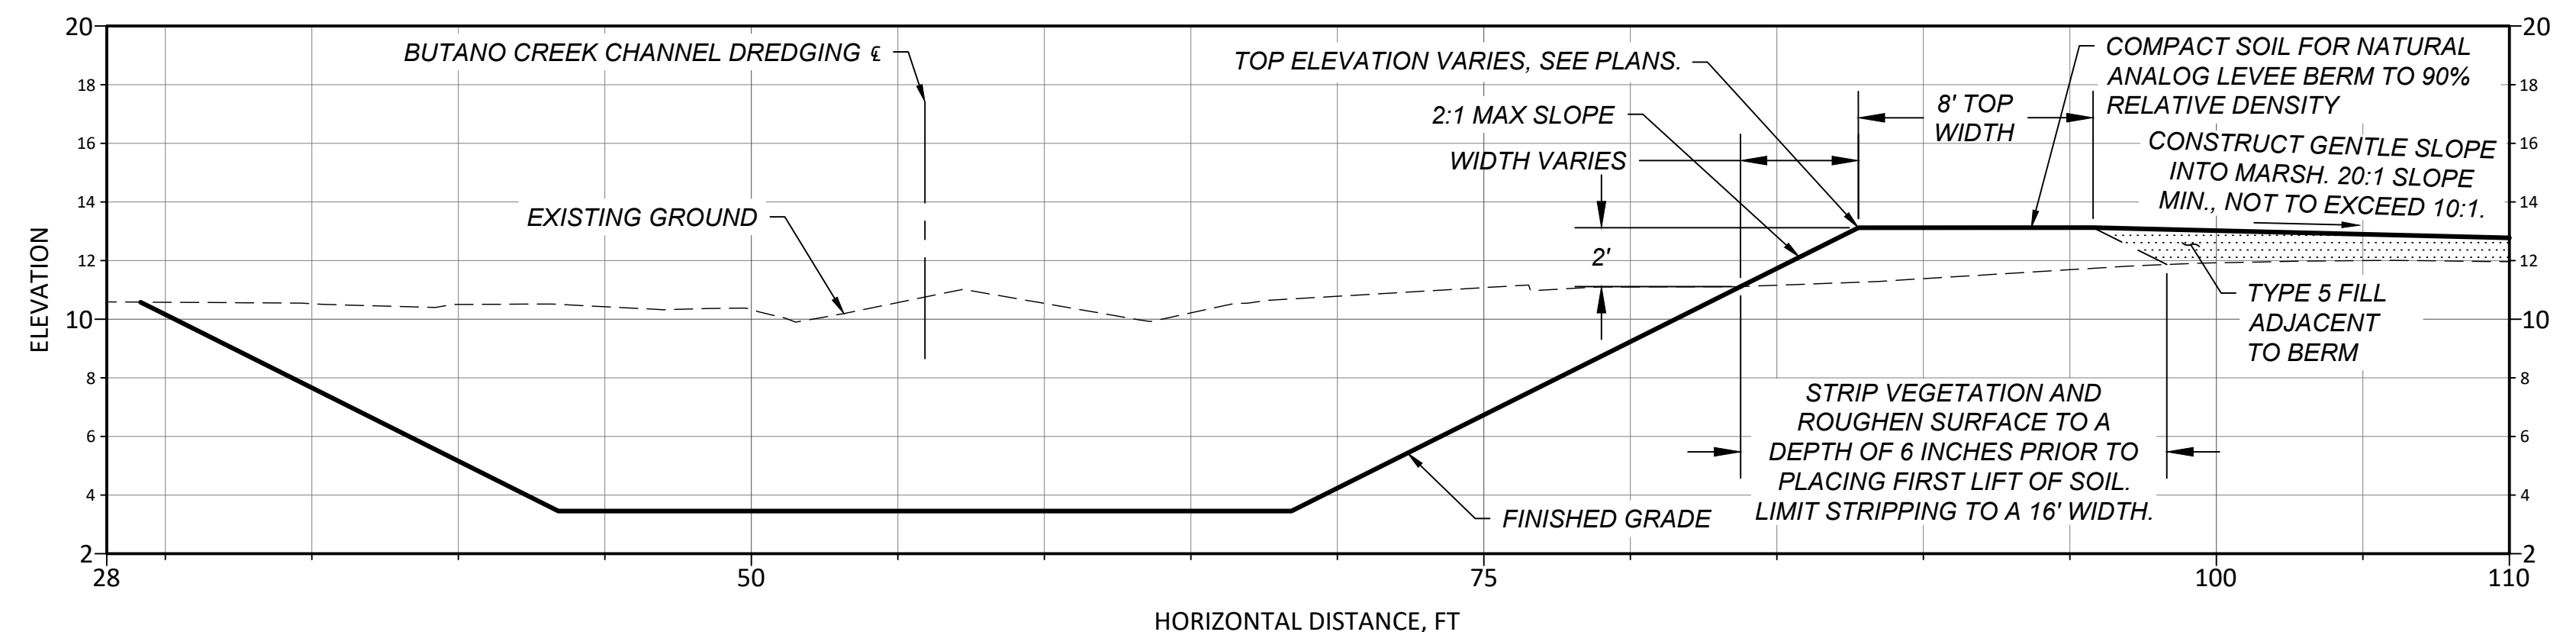

UPPER BUTANO MARSH NATURAL LEVEE ANALOG - TYPICAL SECTION
SCALE: 1"=5'

NOTES:

1. VEGETATION CLEARING AND STRIPPING FOR HAUL ROUTE AND BERM FOOTPRINT SHALL BE DONE IN THE PRESENCE OF A BIOLOGICAL MONITOR.
2. VEGETATION SHALL BE CLEARED IN TWO PASSES. THE FIRST PASS SHALL REDUCE VEGETATION TO 1' ABOVE GROUND. THE SECOND PASS SHALL REDUCE VEGETATION TO 3" ABOVE GROUND.
3. SUBMIT A MOWING AND STRIPPING PLAN TO OWNER'S REPRESENTATIVE FOR APPROVAL.

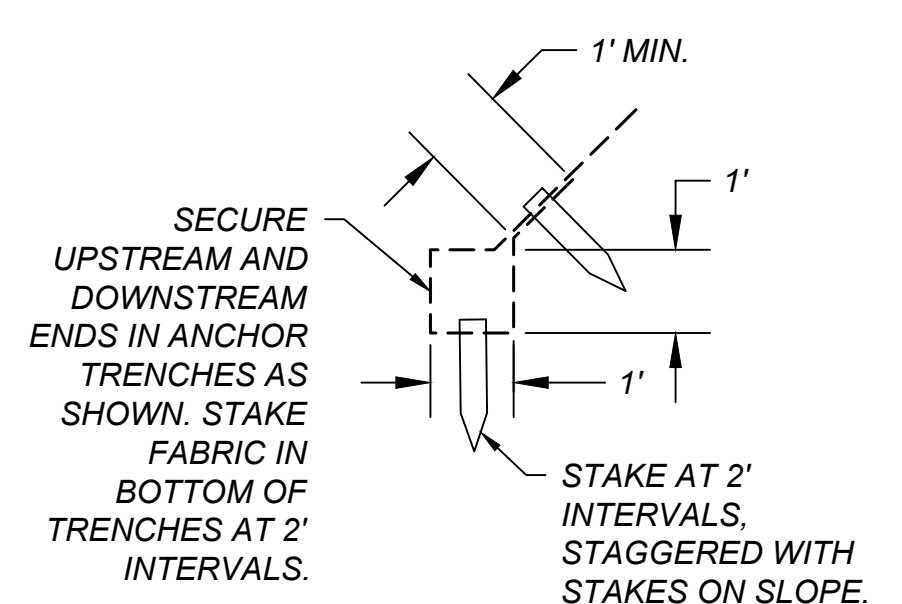

1 ANCHOR TRENCH DETAIL
C14 NOT TO SCALE


1

2


3

4


A					B					C					D					E					USE OF DOCUMENTS THIS DOCUMENT, INCLUDING THE INCORPORATED DESIGN, IS THE PROPERTY OF CBEC. IT IS TO BE USED FOR THE PROJECT ONLY AND SHALL NOT BE REPRODUCED OR TRANSMITTED IN ANY FORM OR BY ANY MEANS, ELECTRONIC OR MECHANICAL, WITHOUT WRITTEN AUTHORIZATION OF CBEC, INC.
BUTANO CREEK DREDGE CHANNEL ALIGNMENT GEOMETRY					BUTANO CREEK DREDGE CHANNEL ALIGNMENT GEOMETRY					BUTANO CREEK DREDGE CHANNEL ALIGNMENT GEOMETRY					BUTANO CREEK DREDGE CHANNEL ALIGNMENT GEOMETRY					BUTANO CREEK DREDGE CHANNEL ALIGNMENT GEOMETRY					
NUMBER	LENGTH	RADIUS	START POINT	END POINT	NUMBER	LENGTH	RADIUS	START POINT	END POINT	NUMBER	LENGTH	RADIUS	START POINT	END POINT	NUMBER	LENGTH	RADIUS	START POINT	END POINT	NUMBER	LENGTH	RADIUS	START POINT	END POINT	
C1	155.8	191	E:6006674.63 N: 1923562.50	E: 6006633.16 N: 1923416.76	C21	20.3	54	E:6008200.37 N: 1922342.72	E: 6008204.81 N: 1922322.99	C40	57.2	3200	E:6007529.70 N: 1921419.13	E: 6007498.56 N: 1921371.20	C59	119.8	2321	E:6007756.29 N: 1920984.54	E: 6007864.21 N: 1920932.53						
C2	50.1	243	E:6006633.16 N: 1923416.76	E: 6006634.54 N: 1923366.81	C22	62.2	1721	E:6008204.81 N: 1922322.99	E: 6008205.70 N: 1922260.80	C41	24.0	173	E:6007498.56 N: 1921371.20	E: 6007486.74 N: 1921350.36	C60	9.1	20	E:6007864.21 N: 1920932.53	E: 6007871.08 N: 1920926.72						
C3	151.5	1214	E:6006634.54 N: 1923366.81	E: 6006613.74 N: 1923216.80	C23	28.1	168	E:6008205.70 N: 1922260.80	E: 6008203.25 N: 1922232.87	C42	14.4	523	E:6007486.74 N: 1921350.36	E: 6007480.72 N: 1921337.30	L3	132.6		E: 6007871.08 N: 1920926.72	E: 6007950.49 N: 1920820.56						
C4	127.4	237	E:6006613.74 N: 1923216.80	E: 6006622.43 N: 1923091.21	C24	49.5	354	E:6008203.25 N: 1922232.87	E: 6008191.48 N: 1922184.85	C43	8.4	18	E:6007480.72 N: 1921337.30	E: 6007475.63 N: 1921330.66	C61	21.7	539	E:6007950.49 N: 1920820.56	E: 6007963.13 N: 1920802.94						
C5	73.7	82	E:6006622.43 N: 1923091.21	E: 6006672.82 N: 1923040.85	C25	32.6	196	E:6008191.48 N: 1922184.85	E: 6008184.14 N: 1922153.09	C44	31.6	1960	E:6007475.63 N: 1921330.66	E: 6007451.24 N: 1921310.52	L4	158.6		E: 6007963.13 N: 1920802.94	E: 6008052.96 N: 1920672.20						
C6	35.9	54	E:6006672.82 N: 1923040.85	E: 6006700.52 N: 1923019.05	C26	42.6	62	E:6008184.12 N: 1922152.97	E: 6008164.03 N: 1922116.32	C45	36.4	3204	E:6007451.24 N: 1921310.52	E: 6007423.47 N: 1921286.94	C62	19.5	58	E:6008052.96 N: 1920672.20	E: 6008061.10 N: 1920654.62						
C7	145.3	966	E:6006700.52 N: 1923019.05	E: 6006770.04 N: 1922891.58	L1	213.9		E: 6008164.03 N: 1922116.32	E: 6008004.25 N: 1921974.16	C46	19.8	103	E:6007423.47 N: 1921286.94	E: 6007409.79 N: 1921272.70	C63	51.3	374	E:6008061.10 N: 1920654.62	E: 6008077.88 N: 1920606.22						
C8	278.5	582	E:6006770.04 N: 1922891.58	E: 6006939.85 N: 1922674.25	C27	26.3	297	E:6008004.25 N: 1921974.16	E: 6007984.98 N: 1921956.20	C47	52.2	68	E:6007409.79 N: 1921272.70	E: 6007395.58 N: 1921223.85	C64	16.5	52	E:6008077.88 N: 1920606.22	E: 6008086.60 N: 1920592.31						
C9	47.8	1320	E:6006939.85 N: 1922674.25	E: 6006976.84 N: 1922643.95	C28	190.7	1208	E:6007984.98 N: 1921956.20	E: 6007830.68 N: 1921844.40	C48	25.3	55	E:6007395.58 N: 1921223.85	E: 6007403.75 N: 1921200.19	L5	85.5		E: 6008086.60 N: 1920592.31	E: 6008142.77 N: 1920527.85						
C10	207.5	524	E:6006976.84 N: 1922643.95	E: 6007157.07 N: 1922543.93	C29	148.4	670	E:6007830.68 N: 1921844.40	E: 6007713.54 N: 1921753.70	C49	49.4	1684	E:6007403.75 N: 1921200.19	E: 6007430.69 N: 1921158.81	C65	22.1	53	E:6008142.77 N: 1920527.85	E: 6008160.29 N: 1920514.63						
C11	71.7	1546	E:6007157.07 N: 1922543.93	E: 6007224.85 N: 1922520.57	C30	99.5	15132	E:6007713.54 N: 1921753.70	E: 6007642.31 N: 1921684.23	C50	23.6	79	E:6007430.69 N: 1921158.81	E: 6007446.57 N: 1921141.46	C66	87.3	5713	E:6008160.29 N: 1920514.63	E: 6008239.63 N: 1920478.17						
C12	77.1	405	E:6007224.85 N: 1922520.57	E: 6007294.19 N: 1922487.04	C31	36.6	53	E:6007642.31 N: 1921684.23	E: 6007626.64 N: 1921651.96	C51	92.4	3778	E:6007446.57 N: 1921141.46	E: 6007517.65 N: 1921082.48	C67	118.4	15736	E:6008239.63 N: 1920478.17	E: 6008347.38 N: 1920429.16						
C13	48.4	76	E:6007294.19 N: 1922487.04	E: 6007340.61 N: 1922476.43	C32	78.2	210	E:6007626.64 N: 1921651.96	E: 6007604.04 N: 1921577.62	C52	38.3	98	E:6007517.65 N: 1921082.48	E: 6007541.31 N: 1921052.67	C68	78.3	8255	E:6008347.38 N: 1920429.16	E: 6008418.69 N: 1920396.81						
C14	260.5	1531	E:6007340.61 N: 1922476.43	E: 6007600.79 N: 1922479.24	C33	31.8	488	E:6007604.04 N: 1921577.62	E: 6007588.39 N: 1921549.90	C53	13.8	120	E:6007541.31 N: 1921052.67	E: 6007546.93 N: 1921040.03	C69	123.5	16810	E:6008418.69 N: 1920396.81	E: 6008531.59 N: 1920346.73						
C15	87.6	798	E:6007600.79 N: 1922479.24	E: 6007688.29 N: 1922477.54	C34	19.5	48	E:6007588.39 N: 1921549.90	E: 6007581.89 N: 1921531.70	C54	16.2	20	E:6007546.93 N: 1921040.03	E: 6007557.85 N: 1921028.73	C70	45.3	173	E:6008531.59 N: 1920346.73	E: 6008574.95 N: 1920334.11						
C16	239.9	3892	E:6007688.29 N: 1922477.54	E: 6007928.19 N: 1922478.66	C35	31.9	170	E:6007581.89 N: 1921531.70	E: 6007574.53 N: 1921500.69	C55	39.5	833	E:6007557.85 N: 1921028.73	E: 6007593.94 N: 1921012.76	C71	45.7	1289	E:6008574.95 N: 1920334.11	E: 6008620.02 N: 1920326.35						
C17	107.1	338	E:6007928.19 N: 1922478.66	E: 6008033.03 N: 1922459.09	C36	32.1	9212	E:6007574.53 N: 1921500.69	E: 6007564.17 N: 1921470.32	C56	12.5	31	E:6007593.94 N: 1921012.76	E: 6007606.00 N: 1921009.86	C72	21.9	73	E:6008620.02 N: 1920326.35	E: 6008640.63 N: 1920319.08						
C18	110.5	1304	E:6008033.03 N: 1922459.09	E: 6008138.57 N: 1922426.38	C37	14.7	62	E:6007564.17 N: 1921470.32	E: 6007557.79 N: 1921457.09	C57	7.4	71	E:6007606.00 N: 1921009.86	E: 6007613.34 N: 1921009.25	C73	44.8	53532	E:6008640.63 N: 1920319.08	E: 6008680.12 N: 1920298.00						
C19	25.6	39	E:6008138.57 N: 1922426.38	E: 6008159.44 N: 1922412.45	C38	28.7	209	E:6007557.79 N: 1921457.09	E: 6007540.72 N: 1921434.04	L2	109.2		E: 6007613.34 N: 1921009.25	E: 6007721.49 N: 1920994.52	C74	17.1	228	E:6008680.12 N: 1920298.00	E: 6008694.93 N: 1920289.36						
C20	81.1	336	E:6008159.44 N: 1922412.45	E: 6008200.37 N: 1922342.72	C39	18.6	134	E:6007540.72 N: 1921434.04	E: 6007529.70 N: 1921419.13	C58	36.3	126	E:6007721.49 N: 1920994.52	E: 6007756.29 N: 1920984.54	C75	57.6	1578	E:6008694.93 N: 1920289.36	E: 6008744.15 N: 1920259.36						
BUTANO CREEK DREDGE CHANNEL ALIGNMENT GEOMETRY					BUTANO CREEK DREDGE CHANNEL ALIGNMENT GEOMETRY					BUTANO CREEK DREDGE CHANNEL ALIGNMENT GEOMETRY					BUTANO CREEK DREDGE CHANNEL ALIGNMENT GEOMETRY					BUTANO CREEK DREDGE CHANNEL ALIGNMENT GEOMETRY					
NUMBER	LENGTH	RADIUS	START POINT	END POINT	NUMBER	LENGTH	RADIUS	START POINT	END POINT	NUMBER	LENGTH	RADIUS	START POINT	END POINT	NUMBER	LENGTH	RADIUS	START POINT	END POINT	NUMBER	LENGTH	RADIUS	START POINT	END POINT	
C76	60.7	505	E:6008744.15 N: 1920259.36	E: 6008794.58 N: 1920225.65	C90	30.6	109	E:6009569.26 N: 1919695.52	E: 6009595.27 N: 1919679.60	L11	105.6		E: 6009595.27 N: 1919679.60	E: 6009676.77 N: 1919612.41											
C77	62.6	1368	E:6008794.58 N: 1920225.65	E: 6008845.30 N: 1920188.93	L11	105.6		E: 6009595.27 N: 1919679.60	E: 6009676.77 N: 1919612.41	C91	46.8	190	E:6009676.77 N: 1919612.41	E: 6009708.88 N: 1919578.49											
C78	51.2	1237	E:6008845.30 N: 1920188.93	E: 6008886.87 N: 1920158.99	L12	70.5		E: 6009708.88 N: 1919578.49	E: 6009750.69 N: 1919521.71	L12	70.5		E: 6009708.88 N: 1919578.49	E: 6009750.69 N: 1919521.71											
C79	36.9	190	E:6008886.87 N: 1920158.99	E: 6008914.04 N: 1920134.06	C92	44.4	253	E:6009750.69 N: 1919521.71	E: 6009773.77 N: 1919483.79	C92	44.4	253	E:6009750.69 N: 1919521.71	E: 6009773.77 N: 1919483.79											
C80	30.0	296	E:6008914.04 N: 1920134.06	E: 6008935.20 N: 1920112.74	C93	72.8	306	E:6009773.77 N: 1919483.79	E: 6009813.45 N: 1919422.93	C93	72.8	306	E:6009773.77 N: 1919483.79	E: 6009813.45 N: 1919422.93											
C81	13.6	409	E:6008935.20 N: 1920112.74	E: 6008945.42 N: 1920103.75	L13	86.0		E: 6009813.45 N: 1919422.93	E: 6009868.63 N: 1919356.99	L13	86.0		E: 6009813.45 N: 1919422.93	E: 6009868.63 N: 1919356.99											
C82	7.0	81	E:6008945.42 N: 1920103.75	E: 6008950.90 N: 1920099.48	C94	36.5	200	E:6009868.63 N: 1919356.99	E: 6009889.35 N: 1919327.06	C94	36.5	200	E:6009868.63 N: 1919356.99	E: 6009889.35 N: 1919327.06											
L6	105.8		E: 6008																						

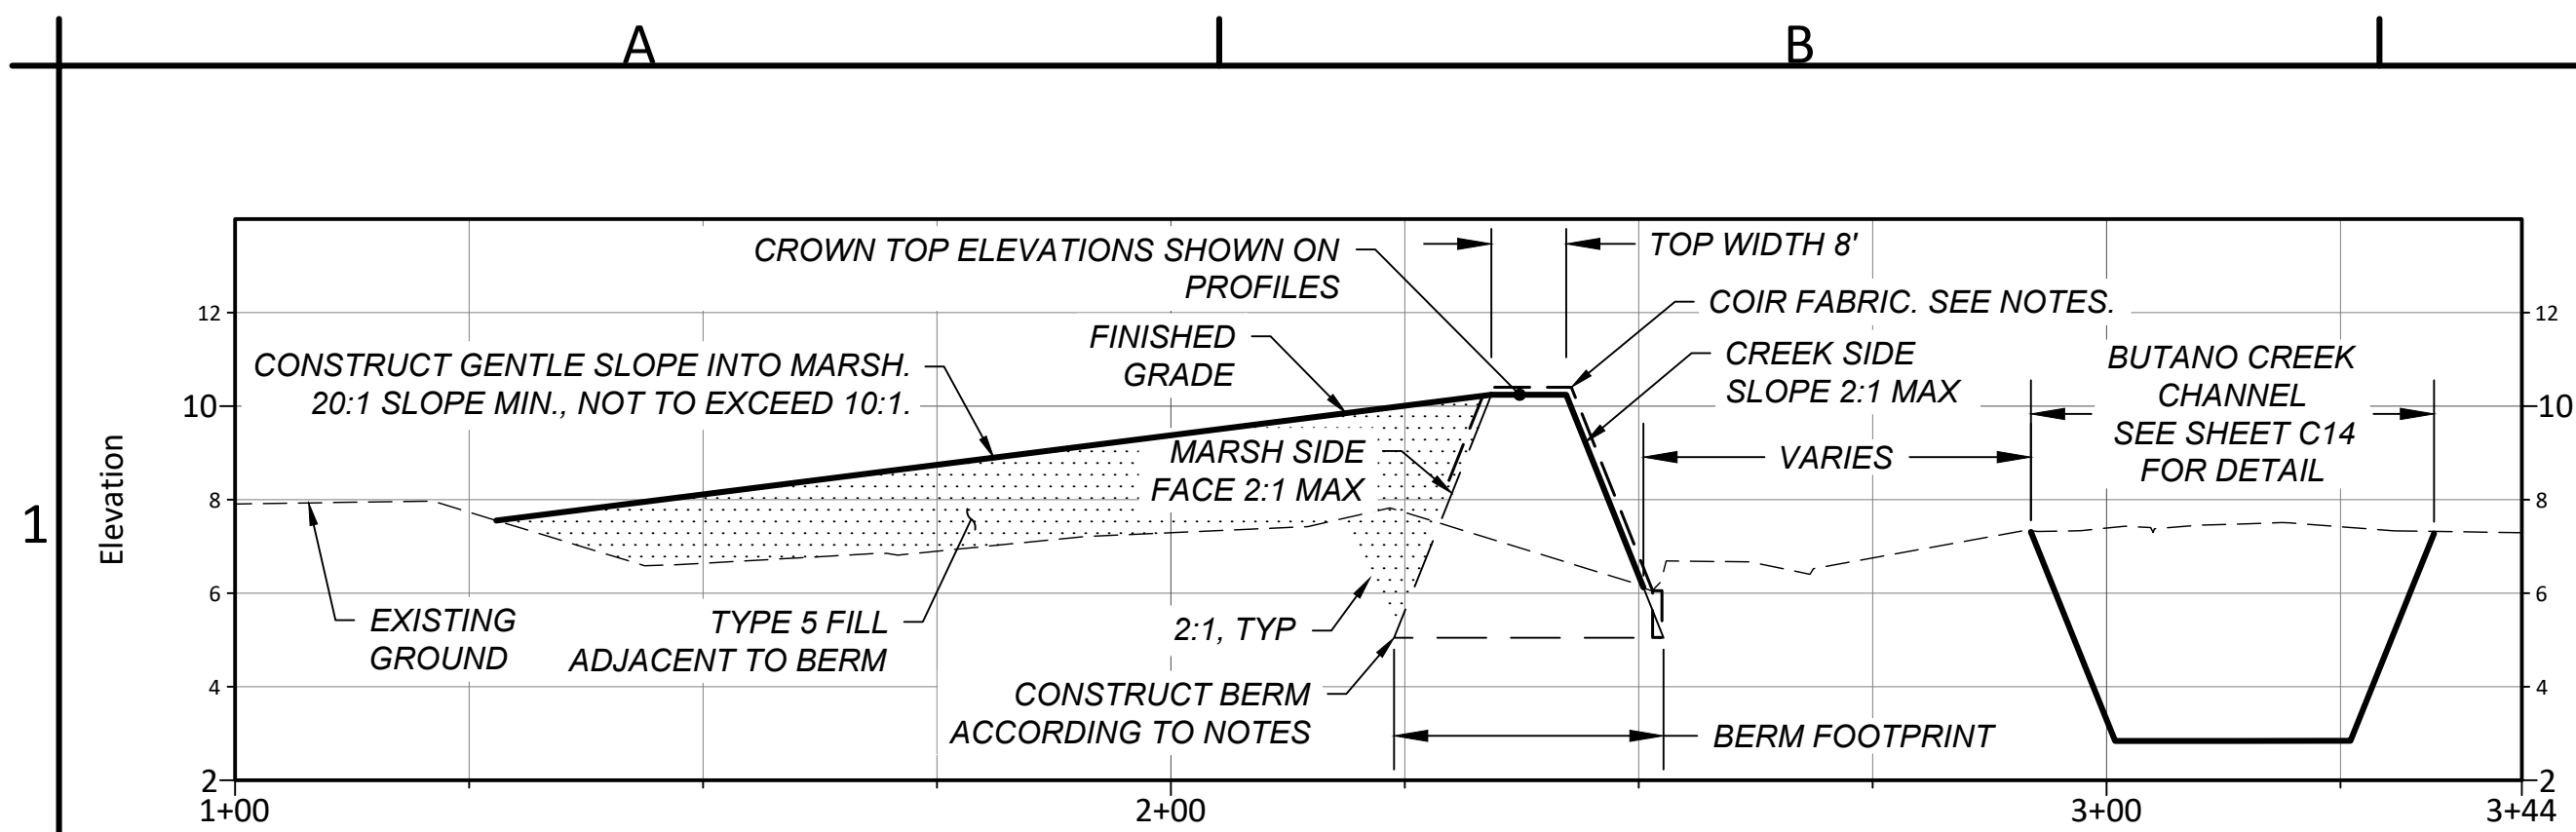

WATER QUALITY BERM ENHANCEMENT TYPICAL SECTION
SCALE: HORIZONTAL 1"=20', VERTICAL 1"=4'

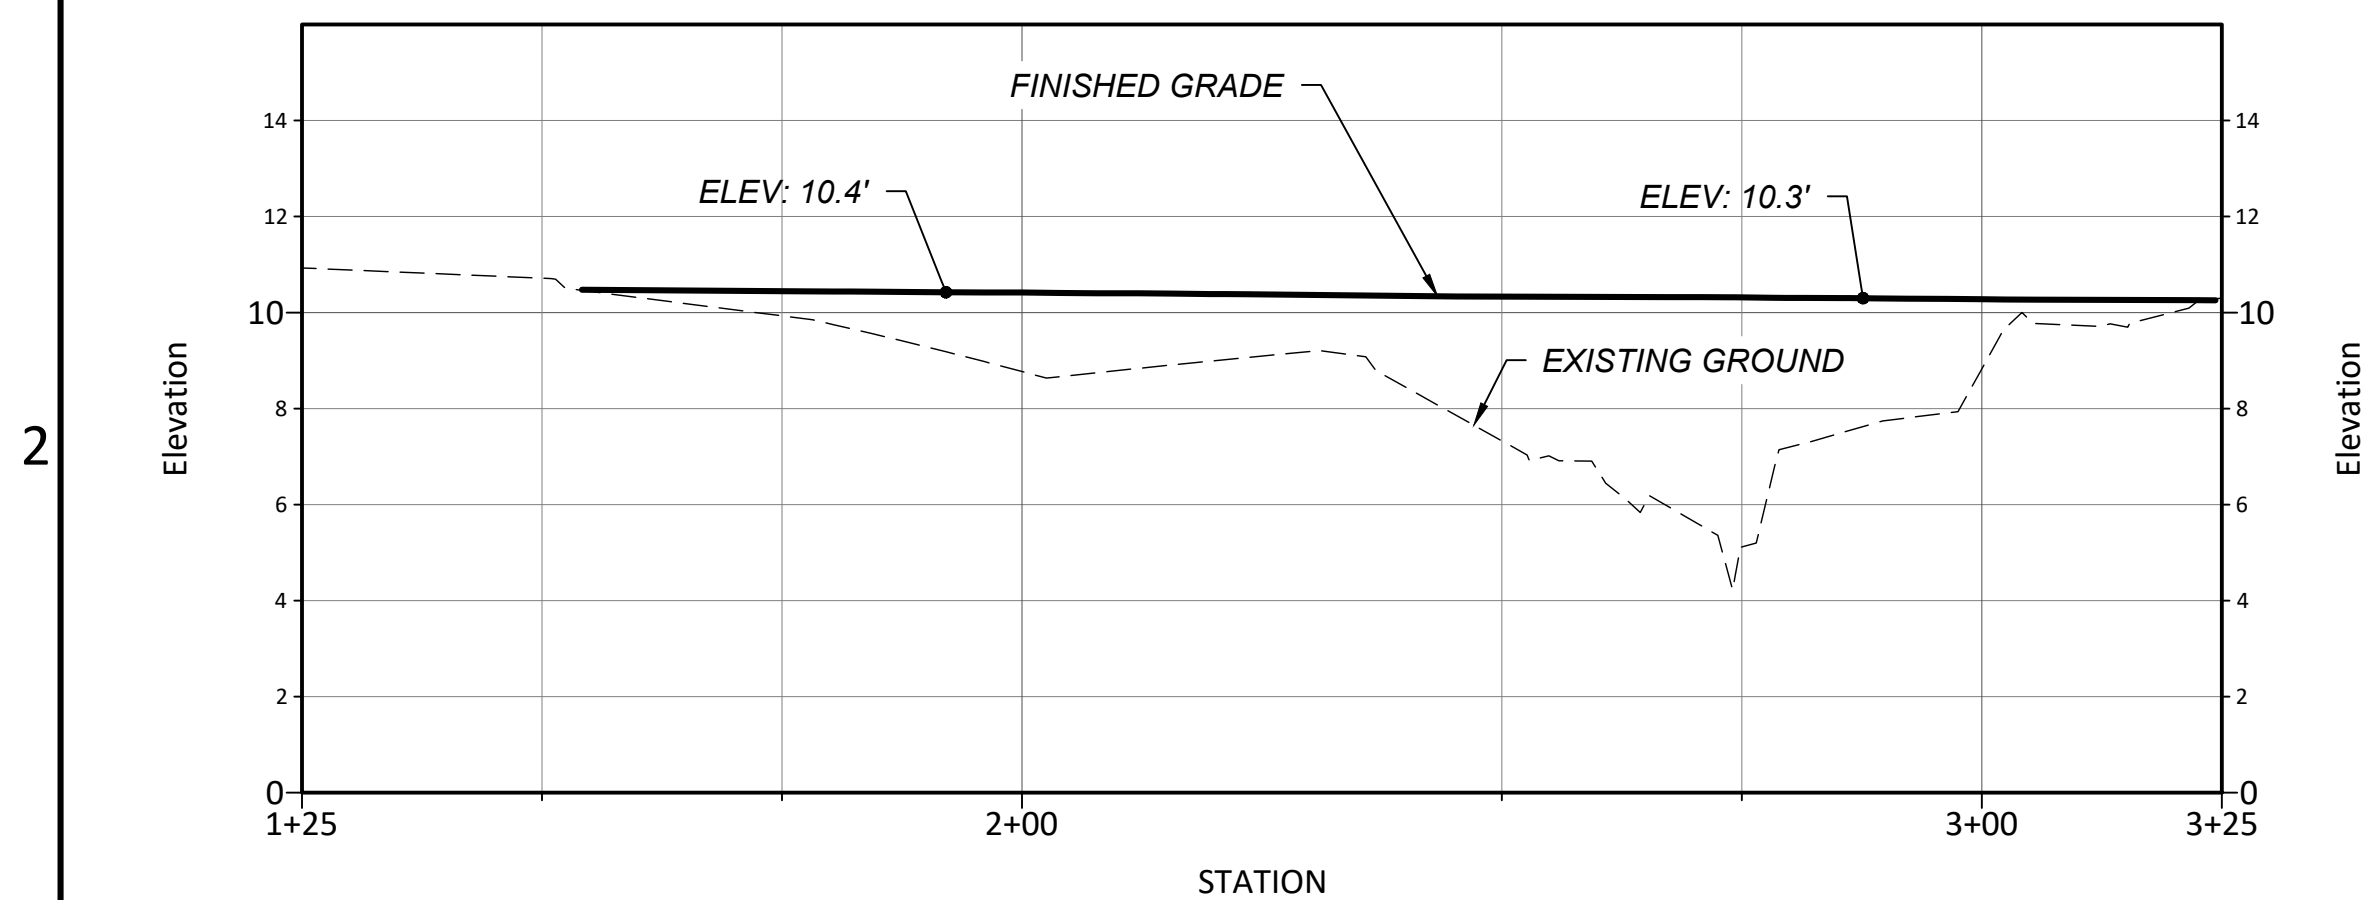



WATER QUALITY BERM ENHANCEMENT #2 PROFILE
 SCALE: HORIZONTAL 1"=20', VERTICAL 1"=4'

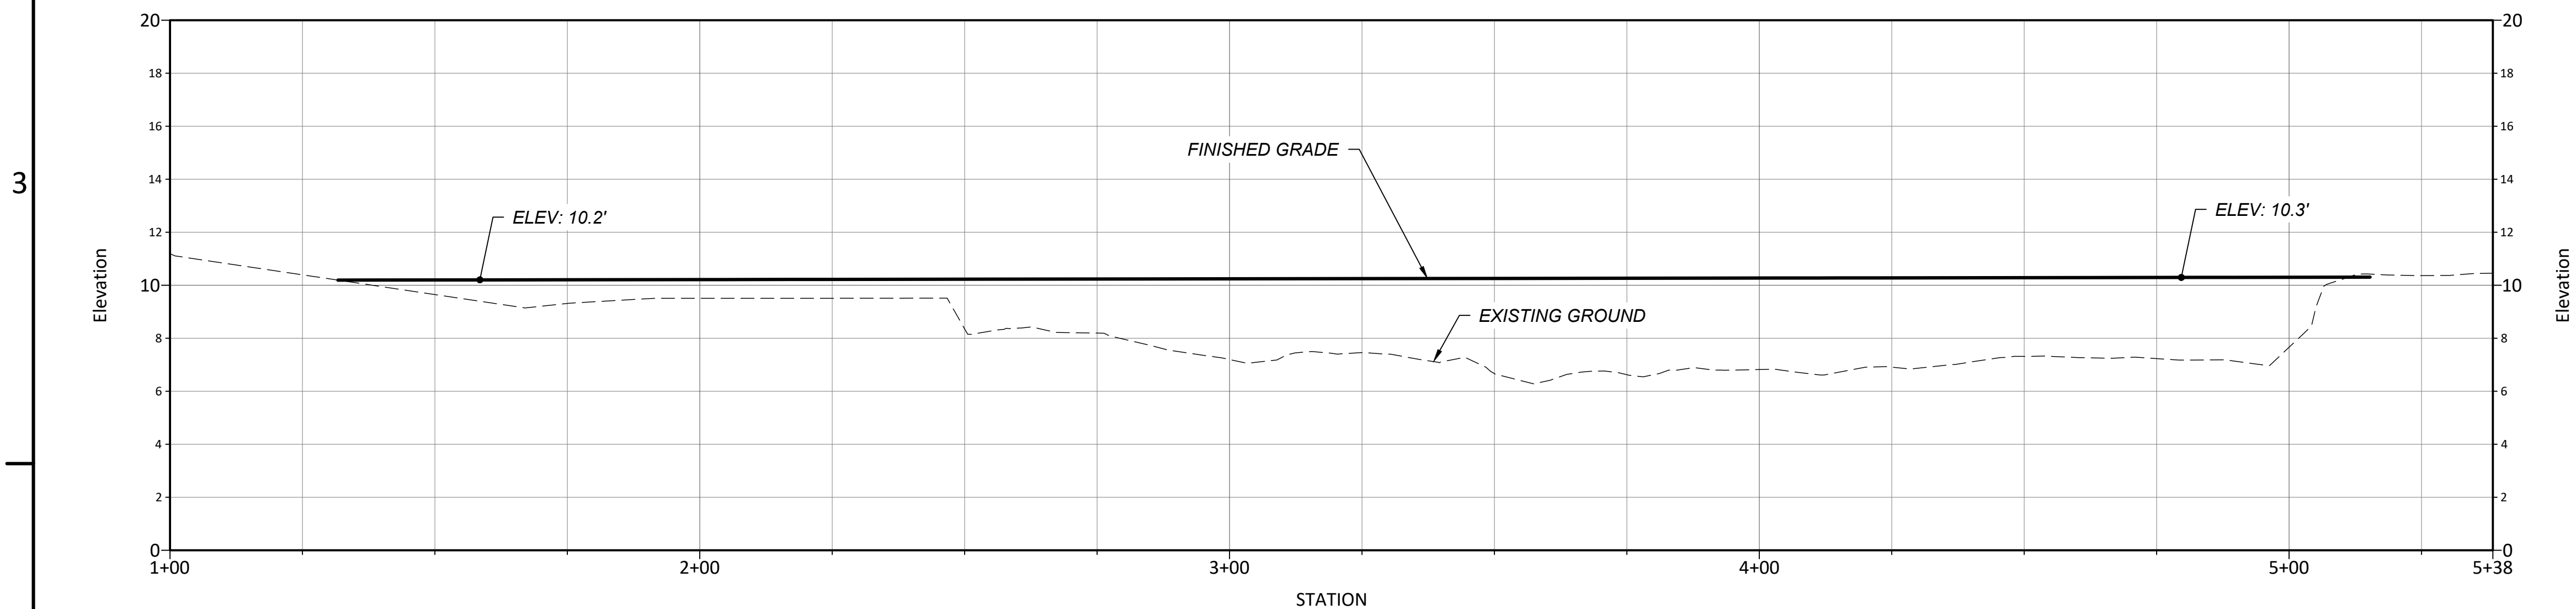




WATER QUALITY BERM ENHANCEMENT #1 PROFILE
SCALE: HORIZONTAL 1"=20', VERTICAL 1"=4'

NOTES:

- | | |
|---|--|
| <p>1. CONSTRUCT BERM OF COMPETENT MATERIAL EXCAVATED FROM BUTANO CREEK CHANNEL THAT IS FREE OF CONCENTRATIONS OF ORGANIC MATERIAL, CONTAMINATED OR DELETERIOUS MATERIAL, AND DEBRIS AND PARTICLES GREATER THAN 3 INCHES IN MAXIMUM DIMENSION. COMPACT APPROVED NATIVE MATERIAL TO 90% OF MAXIMUM RELATIVE DENSITY IN LIFTS NO GREATER THAN 8 INCHES.</p> <p>2. EXCAVATE NATIVE SOIL IN BERM FOOTPRINT BY 1' MINIMUM BELOW EXISTING GROUND TO CREATE A LEVEL FOUNDATION AND A KEY FOR THE BERM.</p> <p>3. PRIOR TO COMPACTION OF NATIVE MATERIAL SCARIFY NATIVE SUBGRADE TO A DEPTH OF 6 INCHES, UNIFORMLY MOISTURE-CONDITION OR AERATE TO NEAR OPTIMUM MOISTURE CONTENT AND COMPACT TO AT LEAST 90% RELATIVE COMPACTION. IF A PUMPING CONDITION IS OBSERVED, FILL SHALL BE REMOVED, MOISTURE REMOVED AND RECOMPACTED UNTIL SPECIFIED COMPACTION IS ACHIEVED AND PUMPING NO LONGER OCCURS.</p> | <p>PENETRATION OF ROOTS. LOOSEN TOP 4 INCHES OF SOIL ON CREEK SIDE FACE AND CROWN PRIOR TO SEEDING. ROUGHEN MARSH SIDE FACE TO 6 INCHES DEPTH PRIOR TO COMPACTING SLOPE FILL ADJACENT TO BERM AGAINST IT.</p> <p>5. TYPE 5 FILL ADJACENT TO BERM - COMPACT TO 80% RELATIVE DENSITY, MAXIMUM.</p> <p>6. INSTALL COIR FABRIC BY UNROLLING ROLL FROM WATERSIDE TO LANDSIDE OF BERM. INSTALL ROWS OF FABRIC WORKING FROM DOWNSTREAM TO UPSTREAM END OF BERM SO COIR FABRIC IS "SHINGLED" TO THE FLOW.</p> <p>7. COIR FABRIC INSTALLATION SHALL EXTEND 5' UPSTREAM OF THE LONGITUDINAL EXTENTS OF THE BERM. TERMINATE COIR FABRIC IN AN ANCHOR TRENCH ON THE CREEK SIDE. SEE DETAIL 1, SHEET C14. STAKE AND BURY COIR FABRIC UNDER FILL ADJACENT TO BERM ON MARSH SIDE.</p> |
|---|--|

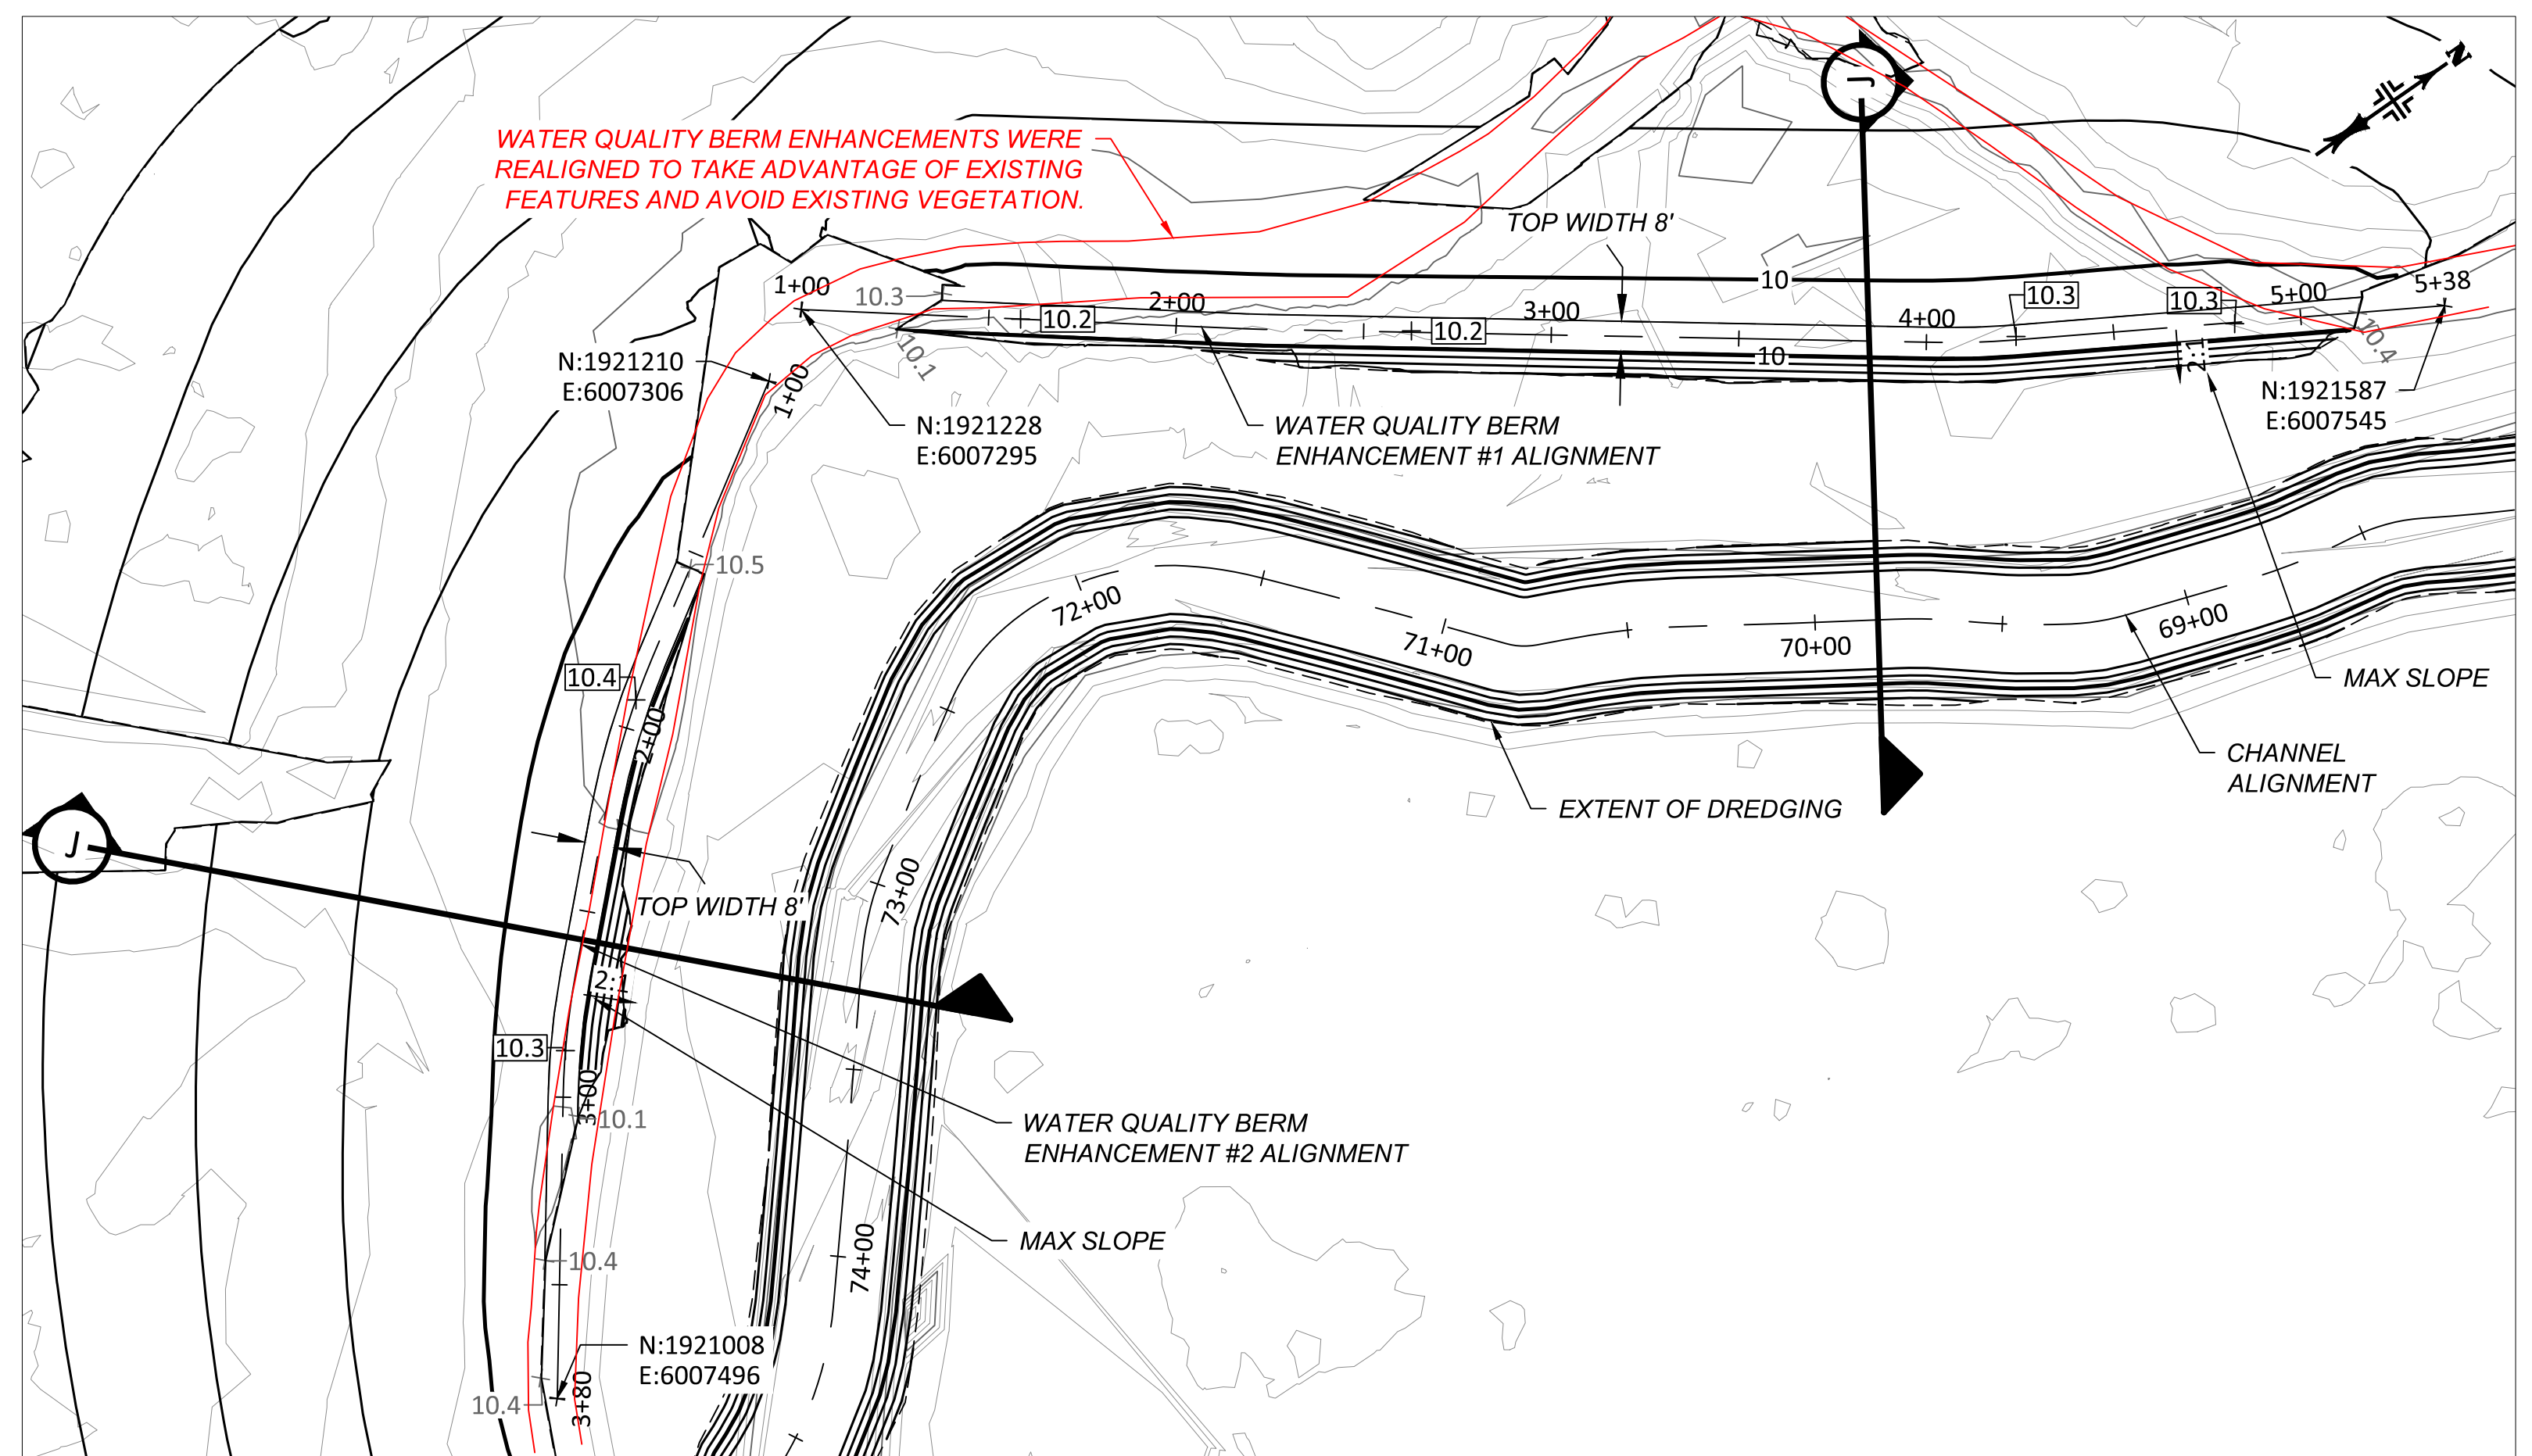

WATER QUALITY BERM ENHANCEMENT PLAN
SCALE: 1"=40'

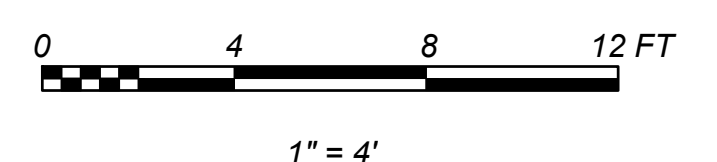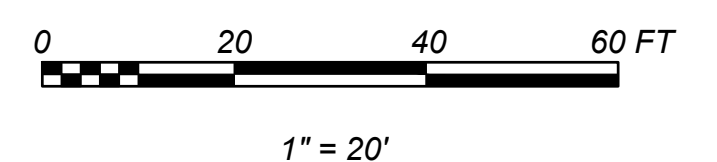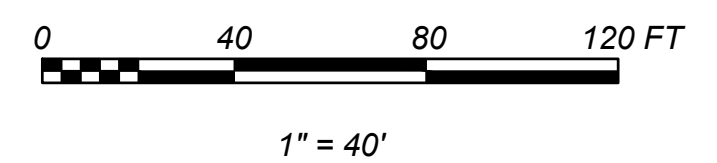

CH/JS/SD	DOCUMENT RELEASE	USE OF DOCUMENTS THIS DOCUMENT, INCLUDING THE INCORPORATED DESIGNS, IS AN INSTRUMENT OF SERVICE FOR THIS PROJECT AND IS NOT TO BE USED FOR ANY OTHER PROJECT WITHOUT THE WRITTEN AUTHORIZATION OF cbeac, inc.
DRAWN	AS-BUILT	
REVIEWED	REVISION NOTES	
SD		
APPROVED		
CH		

PREPARED BY:




CLIENT:

**SAN MATEO
RESOURCE
CONSERVATION
DISTRICT**


80 STONE PINE ROAD #100
HALF MOON BAY, CA 94019
(650) 712-7765

ESCADEIRO CALIFORNIA
UTANO CREEK CHANNEL RECONNECTION
AND RESILIENCE PROJECT
WATER QUALITY BERM ENHANCEMENT
DETAILS


OB NUMBER	16-1027-4
DATE	DEC 2019
SHEET	C17 17 OF 19

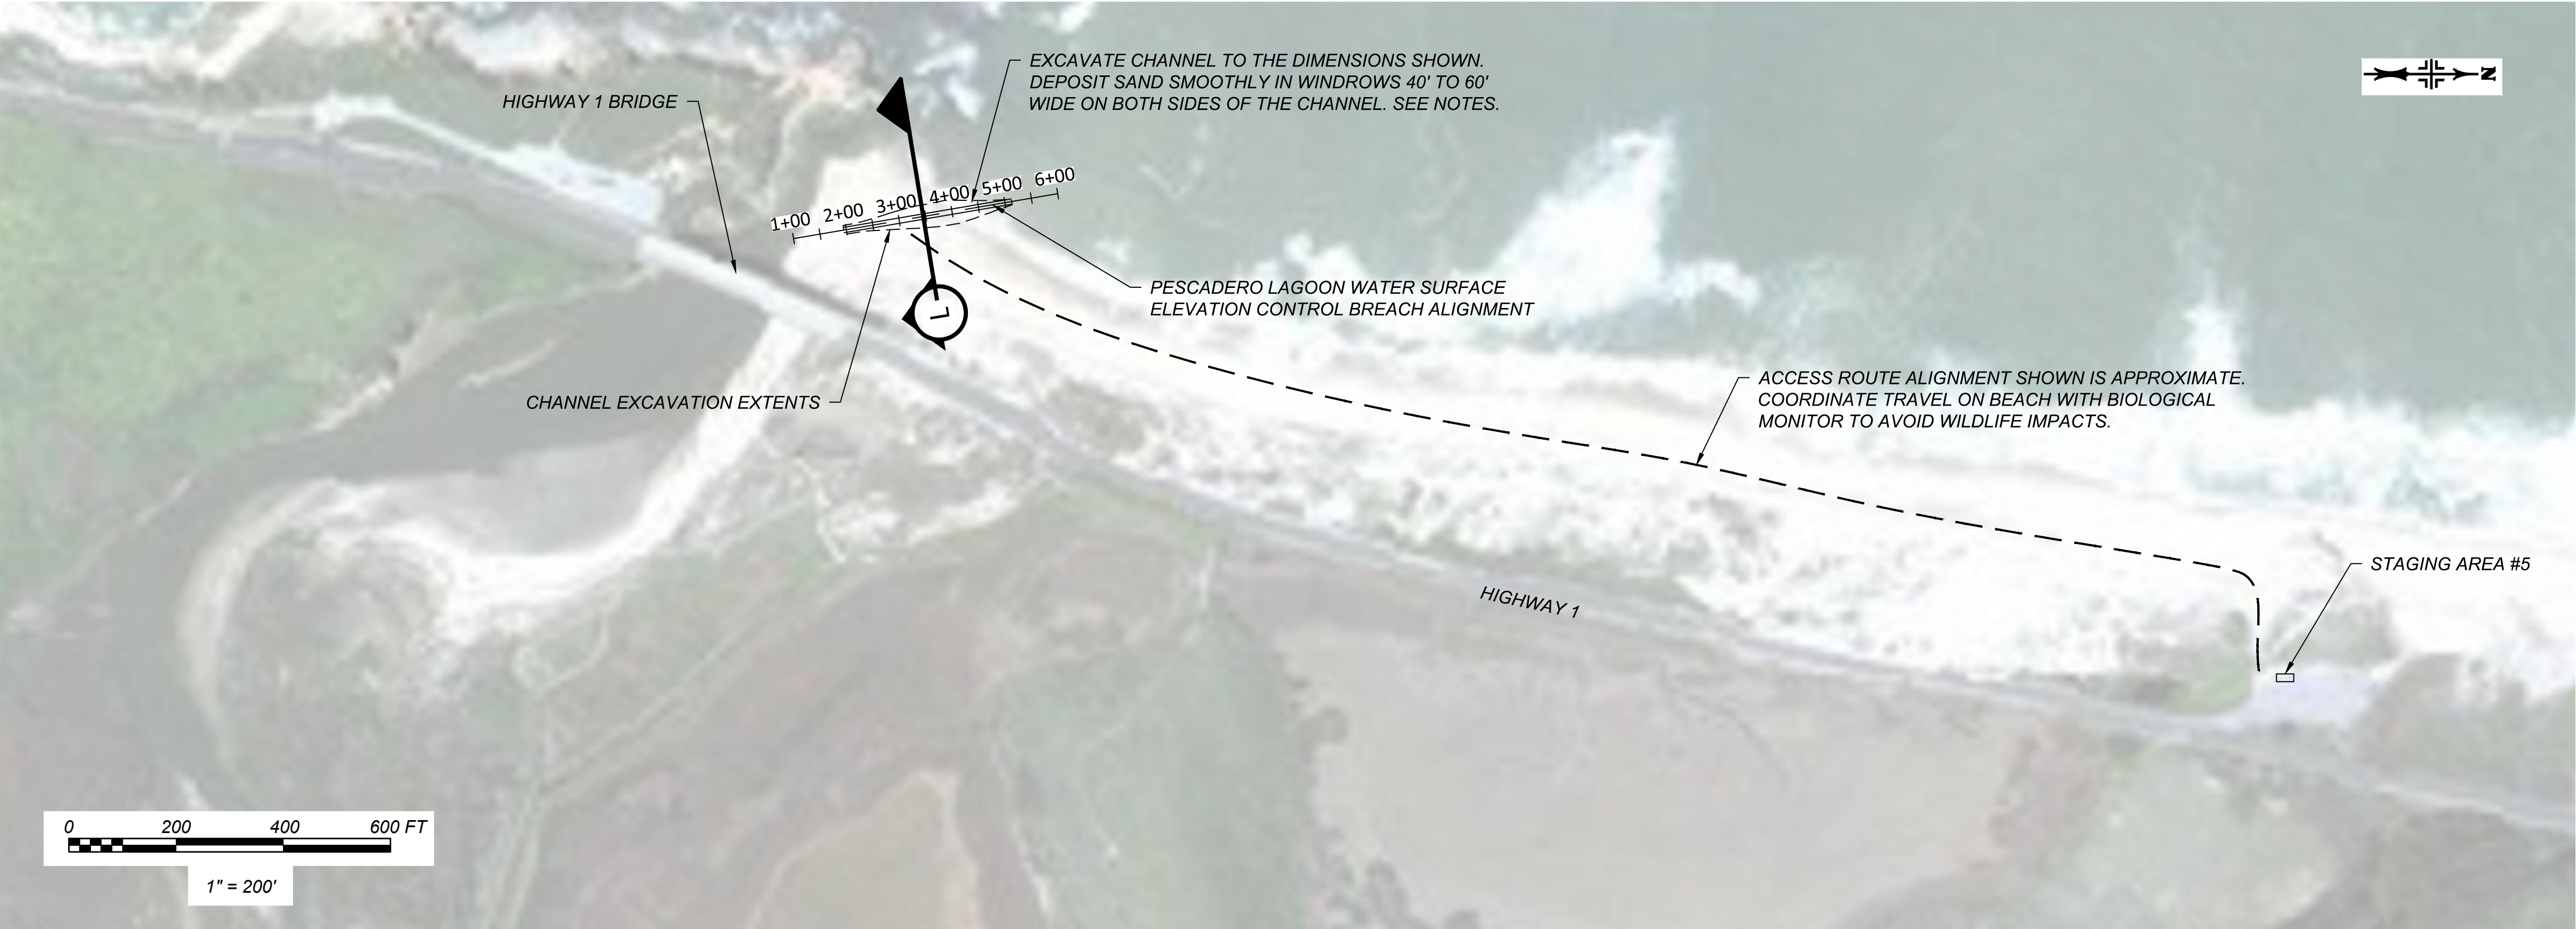

PESCADERO LAGOON WSE CONTROL PLAN
SCALE: 1"=200'

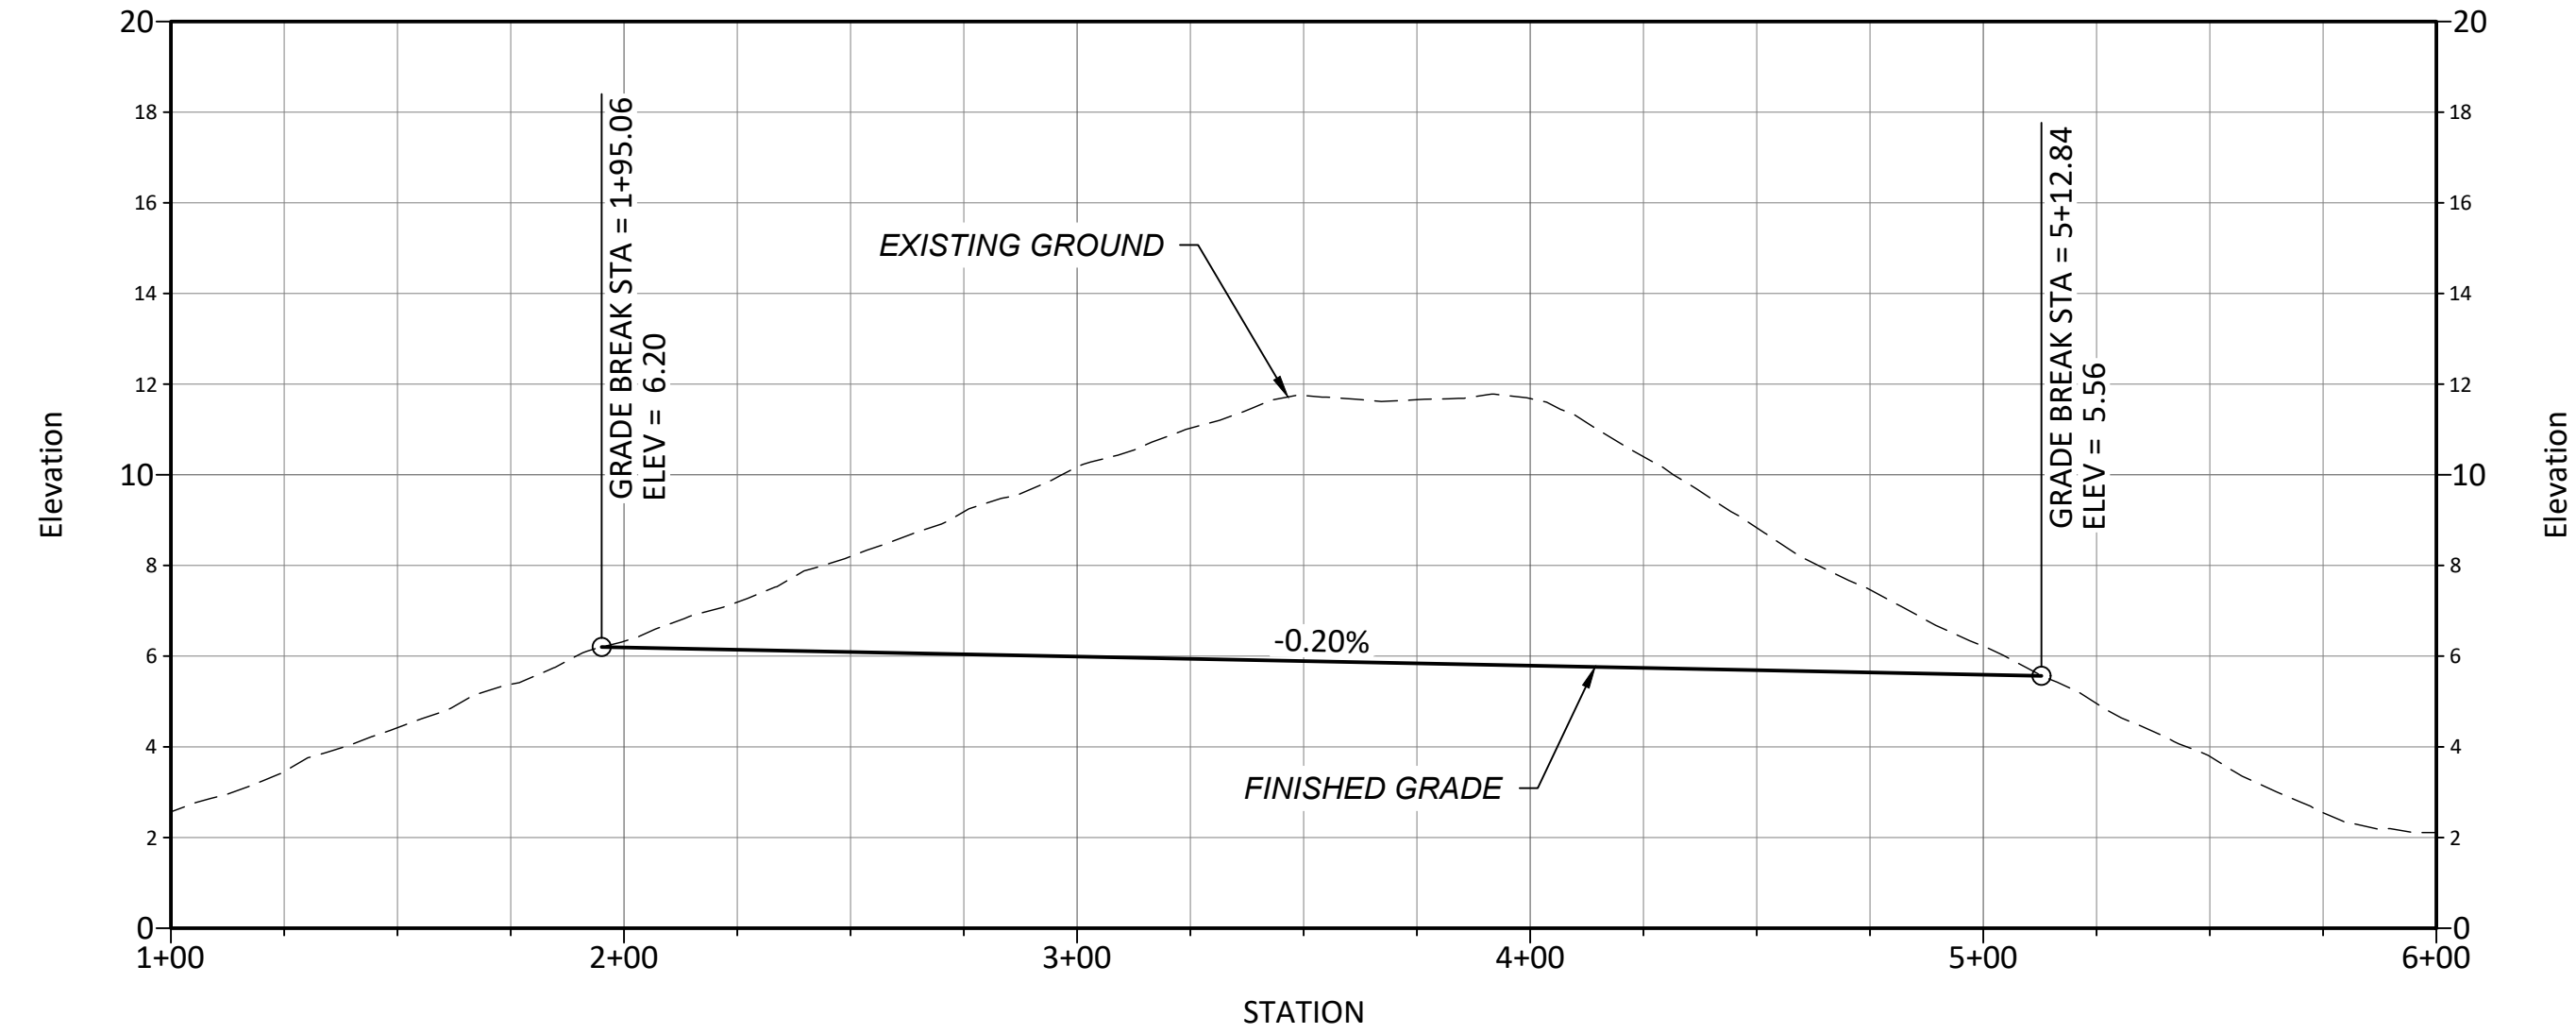


PESCADERO LAGOON WSE CONTROL PROFILE
SCALE: H1"=40'; V1"=4'

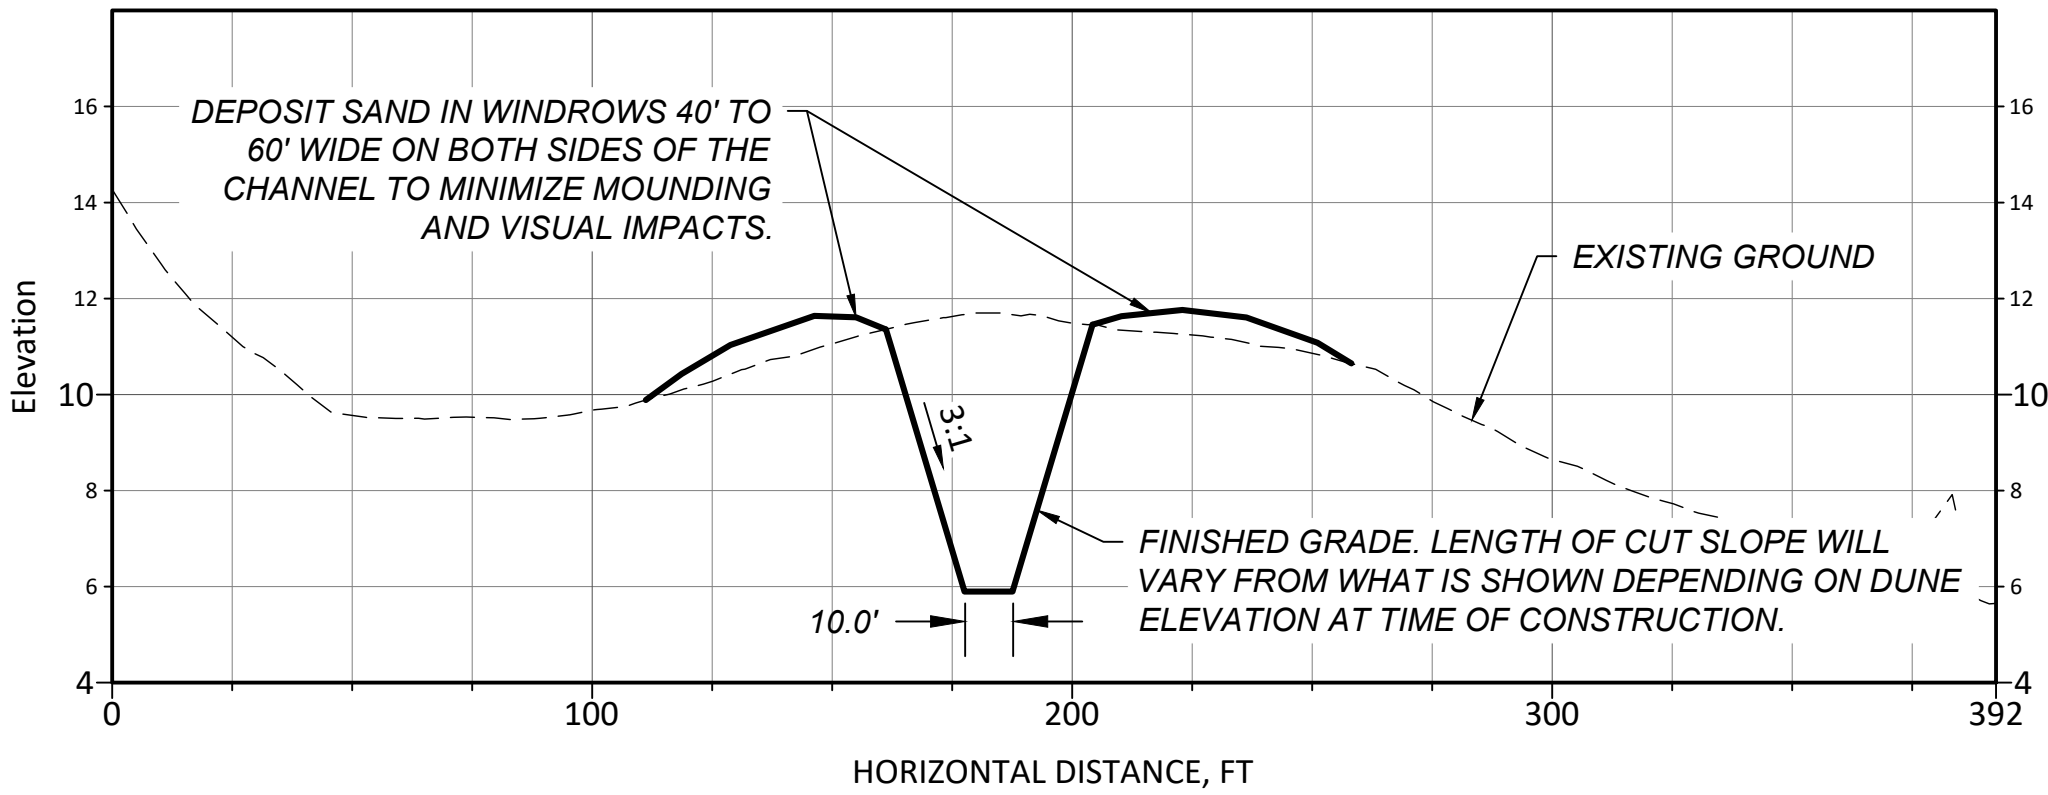

PESCADERO LAGOON WSE CONTROL SECTION
SCALE: H1"=40'; V1"=4'

- NOTES:**
1. PROVIDE A LAGOON BREACHING PLAN TO OWNER'S REPRESENTATIVE FOR APPROVAL PRIOR TO CONSTRUCTING LAGOON BREACH.
 2. WATER LEVEL MANAGEMENT ACTIVITIES WILL ONLY BE IMPLEMENTED FOR LAGOON CONDITIONS WITH WATER SURFACE ELEVATIONS ABOVE 6.5 FT.
 3. BEACH CONDITIONS CHANGE REGULARLY. BERM ELEVATIONS MAY VARY FROM WHAT IS SHOWN ON PLANS. FIELD VERIFY CONDITIONS PRIOR TO CONSTRUCTION.
 4. BREACHING ACTIVITY WILL BE PERFORMED ON AN ADAPTIVE MAINTENANCE BASIS. PERIODIC MAINTENANCE CONSTRUCTION MAY BE NEEDED TO MAINTAIN THE SHAPE OF THE CHANNEL AND LAGOON WATER SURFACE ELEVATIONS BELOW 6.5 FT.
 5. ALL CONSTRUCTION AND BEACH TRAVEL WILL BE PERFORMED IN THE PRESENCE OF BIOLOGICAL MONITORS TO MINIMIZE IMPACTS TO WILDLIFE.
 6. COORDINATE WITH OWNER'S REPRESENTATIVE ON ALIGNMENT OF WATER SURFACE ELEVATION CONTROL CHANNEL PRIOR TO EXCAVATION.

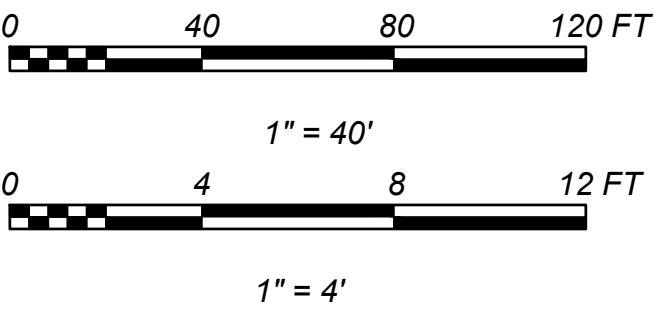

USE OF DOCUMENTS THIS DOCUMENT, INCLUDING THE INCORPORATED DESIGN, IS THE PROPERTY OF CBEC, INC. IT IS TO BE USED FOR THE PROJECT AND SHALL NOT BE REPRODUCED OR USED FOR ANY OTHER PROJECT WITHOUT THE WRITTEN AUTHORIZATION OF CBEC, INC.	DOCUMENT RELEASE FINAL 100%	DESIGNED SD	DRAWN JP	REVIEWED SD	APPROVED CH	PREPARED BY: 	SAN MATEO RESOURCE CONSERVATION DISTRICT 80 STONE PINE ROAD #100 HALF MOON BAY, CA 94019 (650) 712-7765	CLIENT: 	CALIFORNIA BUTANO CREEK CHANNEL RECONNECTION AND RESILIENCE PROJECT PESCADERO LAGOON WATER SURFACE ELEVATION CONTROL
JOB NUMBER 16-1027-3									
DATE OCT 2018									
SHEET C19 19 OF 19									